CI 4'4" ST PT 3'0"

IREDELL COUNTY HEALTH DEPARTMENT

STATESVILLE 704-878-5305 MOORESVILLE 704-664-5281

IMPROVEMENT PERMIT / AUTHORIZATION TO CONSTRUCT / OPERATION PERMIT / EXISTING SYSTEM INSPECTION

PERMIT# 107552 PIN# 4766-62-7692 DATE 09-18-02

OWNER OR CONTRACTOR Williams DEVELOPMENT PHONE: Business 704-202-5286 Home 704-639-0168

ADDRESS 512 KLUMAC ROAD SALISBURY NC 28144

LOCATION NORTH OLD MOORESVILLE, (E) CHESTNUT GROVES (R) 7SPRINGS LOOP, LOT 34 ON RT

SUBDIVISION 7SPRINGS BLOCK / SECTION 1 LOT 34 LOT AREA 1.8409 AC SITE CLASS. PS DESIGN FLOW 480' L.T.A.R. .25

Septic Tank: 1000 Gallons; STB 825 Date 3-5-03
Pump Tank: 1000 Gallons; PT 302 Date 3-8-03
Pump Make: ZOELLER Model N98 Serial No. 90498
Nitrification Field: No Fields 1 Square Feet 1920 Linear Feet 640'
No Lines 6X107' Trench Width 36" Max Trench Bottom Depth 36" Gravel Depth 12"

[X] New System [ ] Repair System Type: I, II, [III] IV, V, VI
System Description: PUMP CONV
Repair System Description: PUMP PANEL/CHAMBERS LP
Maintenance Agreement Required: [ ] Yes [X] No

[X] House/Mod. Home No. Bedrooms 4
[ ] Mobile Home No. Bathrooms 3.5
[ ] Business No. Employees
[ ] Other


[ ] Slab [X] Crawl Space [ ] Basement w/plumbing [ ] Basement wo/plumbing

Water Supply: [ ] Individual [X] Public [ ] Community


Comments/Conditions: (1) TANKS HAVE TO BE TESTED FOR LEAKAGE DUE TO SOIL WETNESS, (2) INSTALL LINES ON CONTOURS (3) MAINTAIN SETBACKS (4) CALL PRIOR TO INSTALLATION FOR PUMP SIZING

Comments/Conditions: INFO: (5) HOUSE NEEDS TO BE PLACED 185' OFF ROAD (6) TANKS MUST BE 15' FROM ANY SWIMMING POOL: 05-13-03 FLAGGED SYSTEM, Williams Development FLAGGED P/L & SYSTEM IS 10' OFF P/L. RICK Williams did the marking of P/L.

INITIAL SITE SKETCH "NOT TO SCALE"

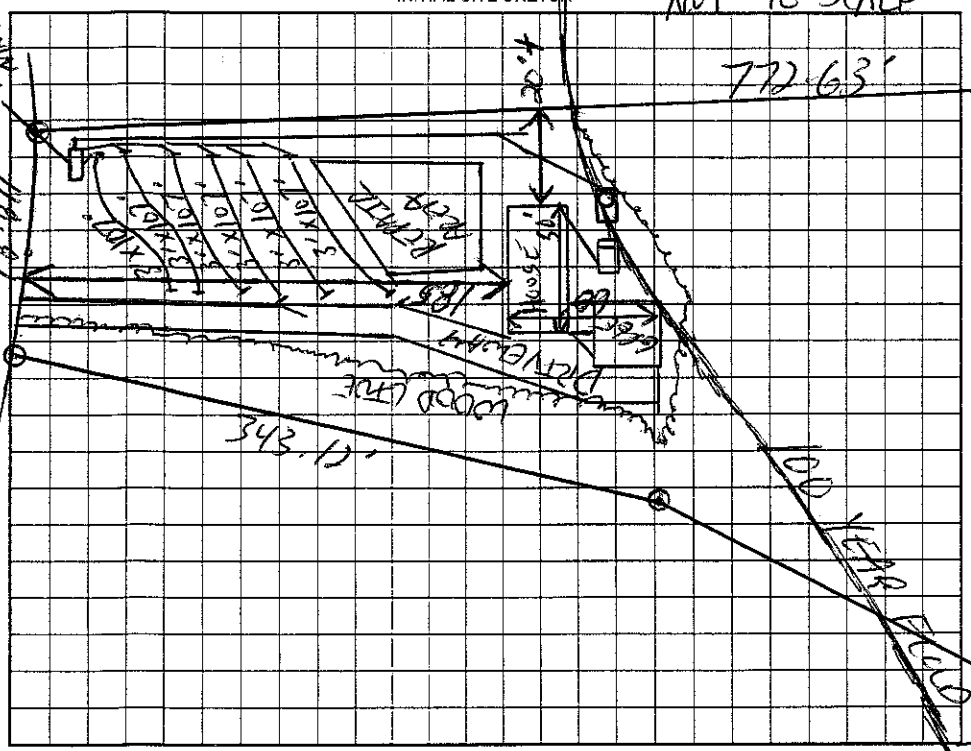

AS BUILT SKETCH

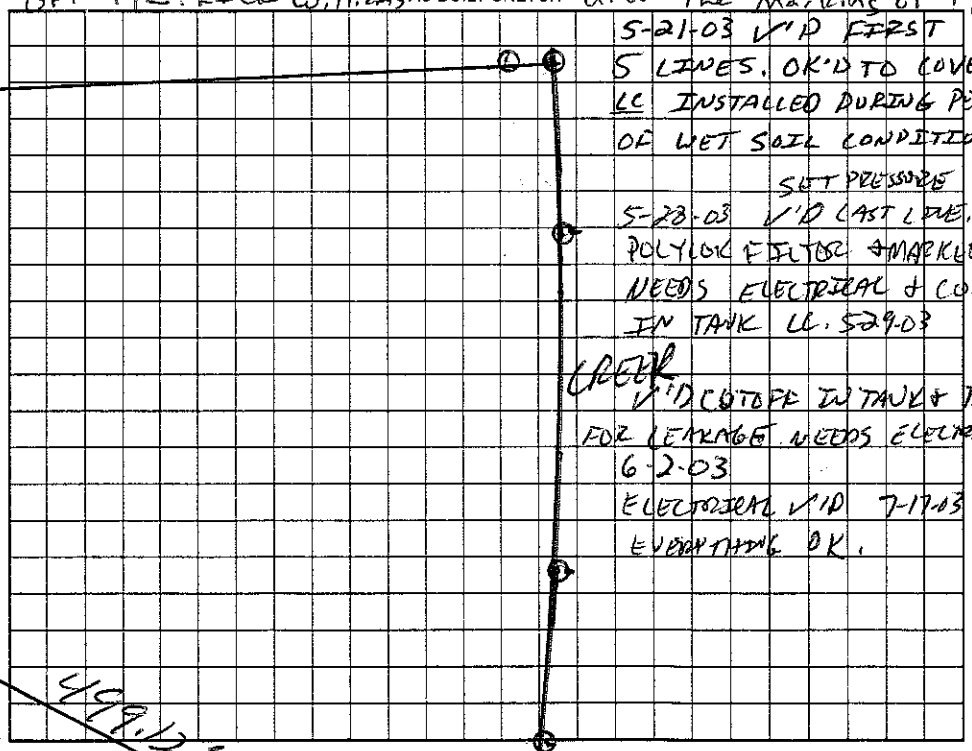

5-21-03 V'D FIRST 5 LINES. OK'D TO COVER LC INSTALLED DURING PERIOD OF WET SOIL CONDITIONS. SET PRESSURE

5-28-03 V'D LAST LINE. OK. POLYLOK FILTER & MARKER NEEDS ELECTRICAL & CUTOFF IN TANK LC. 5-29-03

CHECK V'D CUTOFF IN TANK & TANKS FOR LEAKAGE. NEEDS ELECTRICAL 6-2-03

ELECTRICAL V'D 7-17-03 EVERYTHING OK.

Permit can be suspended or revoked if any false information is supplied toward securing the permit/any unauthorized changes are made to the site/any unauthorized changes are made in the installation of the system. Improvement Permit with plat valid without expiration. Improvement Permit with site plan valid for sixty months. Authorization to Construct is valid for a period equal to that of Improvement Permit – not to exceed sixty months.

Signed: _____ date 9-18-02 Installed by: MIKE BARGER

Improvement Permit by: _____ date 9-18-02 Operation Permit by: _____ date 7-17-03

Authorization to Construct by: _____ date 9-18-02 Existing System Inspection by: _____ date _____

HEALTH DEPT. COPY: WHITE OWNER COPY (FINAL): YELLOW OWNER COPY (INITIAL): PINK