IREDELL COUNTY HEALTH DEPARTMENT

STATESVILLE 704-878-5305 MOORESVILLE 704-664-5281

IMPROVEMENT PERMIT / AUTHORIZATION TO CONSTRUCT / OPERATION PERMIT / EXISTING SYSTEM INSPECTION

PERMIT# 089093 PIN# 4766 63 9095 DATE May 22, 2000

OWNER OR CONTRACTOR Shannon Harmon PHONE: Business 876-6755 Home

ADDRESS 737 Turnersburg Hwy Statesville

LOCATION Old Mocksville Rd & TR Chestnut Grove TR Seven Springs on Right

SUBDIVISION Seven Springs BLOCK / SECTION LOT 36 LOT AREA .93 AC SITE CLASS PS DESIGN FLOW 360gpd L.T.A.R. .3

Septic Tank: 1000 Gallons; STB 312 Date 1-8-01

Pump Tank: Gallons; PT Date

Pump Make: Model Serial No.

Nitrification Field: No Fields 1 Square Feet 1200 Linear Feet 400

No Lines 3 Trench Width 36" Max Trench Bottom Depth 36"

☑ New System ☐ Repair System Type: I II III IV V VI

System Description: Gravity Conventional

Repair System Description: Crawlspace conv. innov.

Maintenance Agreement Required: ☐ Yes ☑ No

Gravel Depth 12"

☑ House/Mod. Home No. Bedrooms 3

☐ Mobile Home No. Bathrooms 2

☐ Business No. Employees

☐ Other


☐ Slab ☑ Crawl Space ☐ Basement w/plumbing ☐ Basement wo/plumbing

Water Supply: ☐ Individual ☑ Public ☐ Community


Comments/Conditions: OK to use either single 0 Bay w/ Leaders OR Drop Boxes

Comments/Conditions: INSTALLED WITH RIGID & POLYLOK FILTER
INSTALLED AS SHOWN

1"=50' INITIAL SITE SKETCH

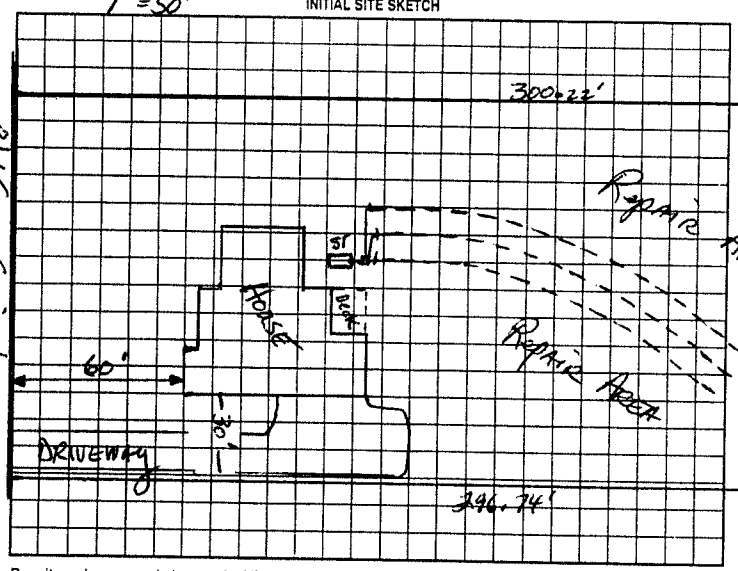

AS BUILT SKETCH

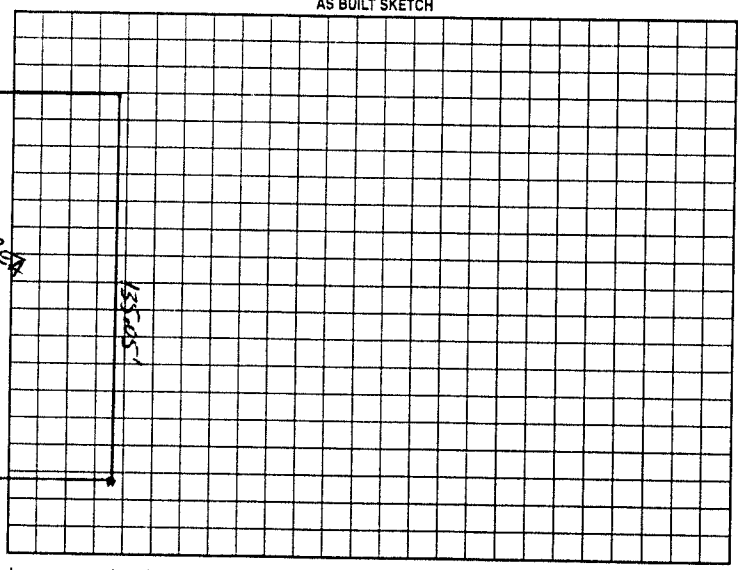

Permit can be suspended or revoked if any false information is supplied toward securing the permit/any unauthorized changes are made to the site/any unauthorized changes are made in the installation of the system. Improvement Permit with plat valid without expiration. Improvement Permit with site plan valid for sixty months. Authorization to Construct is valid for a period equal to that of Improvement Permit – not to exceed sixty months.

(Signed) date 5/30/00 Installed by: TUCKER'S HAULING & GRADING

Improvement Permit by: date 5-22-00 Operation Permit by: date 08-01-01

Authorization to Construct by: date 5-22-00 Existing System Inspection by: date

HEALTH DEPT. COPY: WHITE OWNER COPY (FINAL): YELLOW OWNER COPY (INITIAL): PINK