IREDELL COUNTY HEALTH DEPARTMENT

STATESVILLE 704-878-5305 MOORESVILLE 704-664-5281

IMPROVEMENT PERMIT / AUTHORIZATION TO CONSTRUCT / OPERATION PERMIT / EXISTING SYSTEM INSPECTION

PERMIT# REPAIR PIN# 4766-66-3433 DATE 10-12-06

OWNER OR APPLICANT REX EUGENE McCOY PHONE: Business Home 704-872-5703

ADDRESS 397 CHESTNUT GROVE RD, STATESVILLE NC 28625-9107

LOCATION OLD MOCKSVILLE ROAD, TR CHESTNUT GROVE RD, 2ND HOUSE ON LEFT PAST WOOTEN FARM RD.

SUBDIVISION BLOCK / SECTION LOT LOT AREA 1.75 ACRES SITE CLASS. FS DESIGN FLOW 480 L.T.A.R. 0.30 GAD/FT²

Septic Tank: EXISTING Gallons: STB Date

Pump Tank: Gallons: PT Date

Pump Make: Model Serial No.

Nitrification Field: No Fields 1 Square Feet EQ. FT 400 Linear Feet 100

No Lines ONE Trench Width 36" Max Trench Bottom Depth 36"

☐ New System ☑ Repair ☐ Expansion System Type: I (II) III IV V VI

System Description: CONVENTIONAL

Repair System Description: 25% REDUCTION, GRAVITY

Maintenance Agreement Required: ☐ Yes ☐ No

Gravel Depth N/A ☐ Gravity ☐ Pressure

☑ House/Mod. Home (2) No. Bedrooms 4

☐ Mobile Home No. Persons

☐ Business No. Employees

☐ Other

☐ Slab ☑ Crawl Space ☐ Basement w/plumbing ☐ Basement wo/plumbing


Water Supply: ☑ Individual ☐ Public ☐ Community WELL

Comments:/Conditions: INSTALL NEW 25% REDUCTION SYSTEM

PROPERTY LINE 286'


DRIVEWAY

INITIAL SITE SKETCH

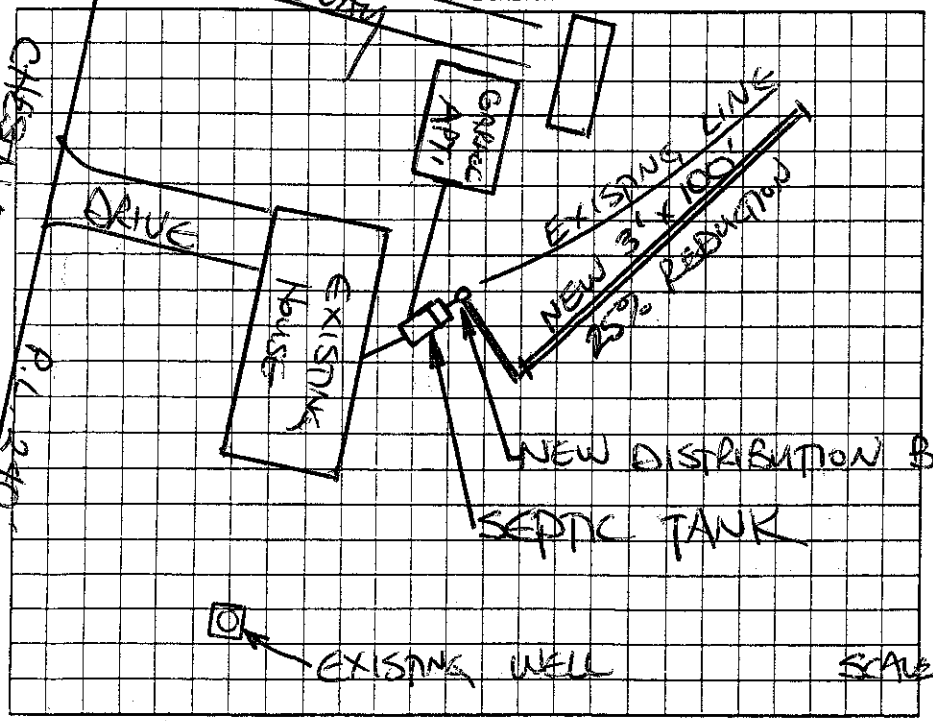

Comments:/Conditions:

AS BUILT SKETCH

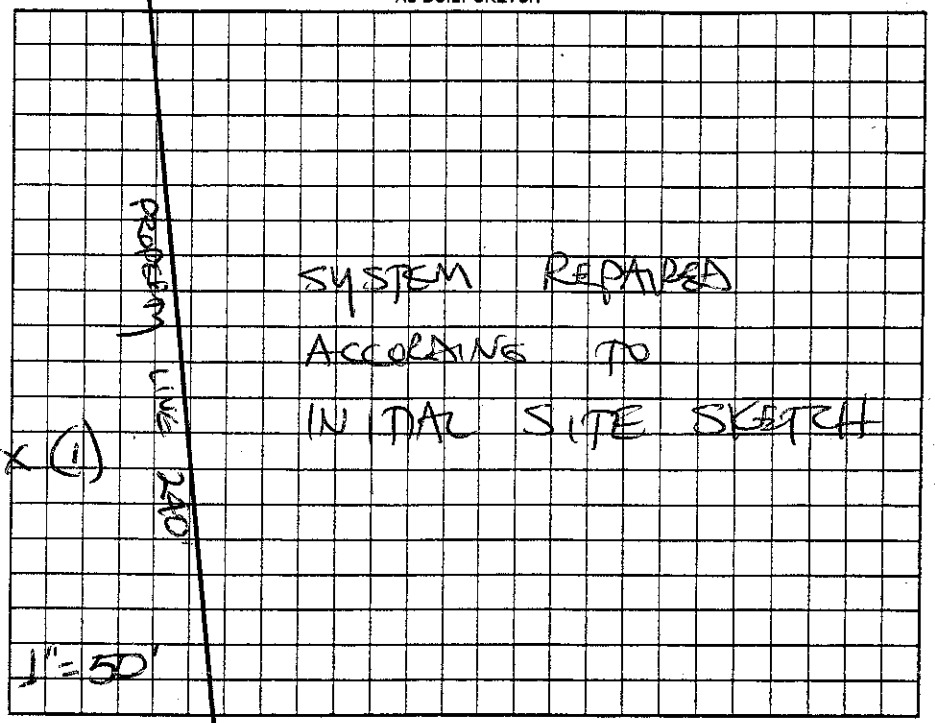

P.L. 360'

Permit can be suspended or revoked if any false information is supplied toward securing the permit/any unauthorized changes are made to the site/any unauthorized changes are made in the installation of the system. Improvement Permit with plat valid without expiration ☐ Improvement Permit with site plan valid for sixty months ☑ Authorization to Construct is valid for a period equal to that of Improvement Permit – not to exceed sixty months.

Signed: Rex Eugene McCoy date 10/12/06 Installed by: PIEDMONT BACKHOE

Improvement Permit by: STEVE HENDRICK date 10-12-06 Operation Permit by: STEVE HENDRICK date 10-19-06

Authorization to Construct by: STEVE HENDRICK date 10-12-06 Existing System Inspection by: date

HEALTH DEPT. COPY: WHITE OWNER COPY (FINAL): YELLOW OWNER COPY (INITIAL): PINK