IREDELL COUNTY HEALTH DEPARTMENT

Statesville Office (704) 878-5305 Mooresville Office (704) 660-3625 PERMIT # 215113

IMPROVEMENT PERMIT / AUTHORIZATION TO CONSTRUCT / OPERATION PERMIT / EXISTING SYSTEM

PIN # 4766673299

APPLICANT: Henry Hall APPLICANT ADDRESS: 180 Shady Stream Dr.

SITE ADDRESS: 108 Moose Farm Rd. PHONE: 704-902-5069 ALT. PHONE: N/A


SITE DIRECTIONS: Old Mocksville Rd to Chestnut Grove Rd TL Wooten Farm TL Moose Farm Rd

SUBDIVISION: N/A SECTION: N/A LOT # N/A LOT AREA: 10.55 acres DESIGN FLOW: 360 gpd L.T.A.R.: 0.275


Septic Tank	1000	(gal)	STB 760-1000	Date 12-4	☑ New System ☐ Repair ☐ Expansion	System Type: I II III IV V VI	☑ Residence	No. Bedrooms	3	Water Supply	
Pump Tank		(gal)	PT	Date	System Description:	25% Reduction	☐ Business	No. Persons	6	☑ Private	
Pump Make		Model		Serial #	Repair System Description:	25% Reduction	☐ Other	No. Employees		☐ Public	
# Nitrification Fields	1	# Lines	4	Linear Ft: 328	Maintenance Agreement Required:	☐ YES ☑ NO	☐ Slab	☑ Crawl Space		☐ Community	
Trench Width	36"	Max. Trench Bottom Depth	36"	Gravel Depth N/A		☑ GRAVITY ☐ PRESSURE	☐ Basement w/plumbing			☐ Basement w/o plumbing	

Comments / Conditions: Install a 25% Reduction system on contour with serial distribution.

INITIAL SITE SKETCH

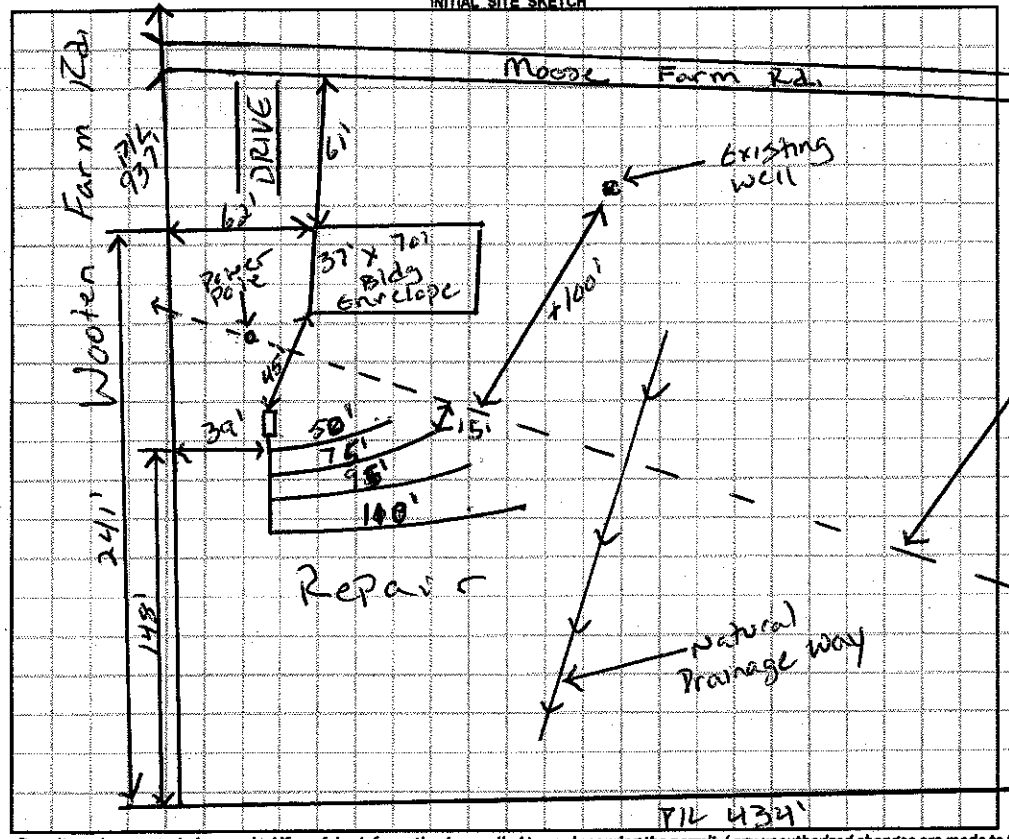

AS BUILT SKETCH

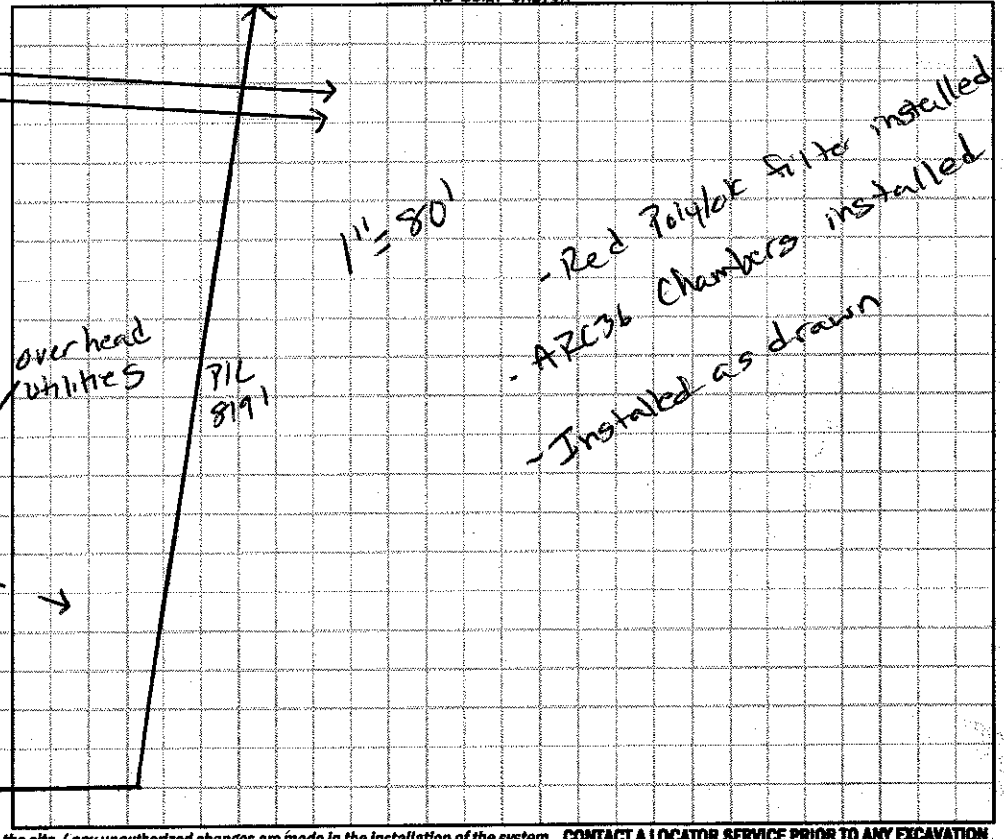

Permit can be suspended or revoked if any false information is supplied toward securing the permit / any unauthorized changes are made to the site / any unauthorized changes are made in the installation of the system. **CONTACT A LOCATOR SERVICE PRIOR TO ANY EXCAVATION**

☐ **IMPROVEMENT PERMIT** *with plot valid without expiration.* ☑ **IMPROVEMENT PERMIT** *with site plan valid for 60 mos.* ☑ **AUTHORIZATION TO CONSTRUCT** *valid for period equal to IMPROVEMENT PERMIT--not to exceed 60 mo.*

Owner / Applicant Signature: Henry Hall Date: 1-11-16 Installed by: Tim Abee

IMPROVEMENT PERMIT by: Justin Henderson Date: 1-8-16 OPERATION PERMIT by: Justin Henderson Date: 3/16/16

AUTHORIZATION TO CONSTRUCT by: Justin Henderson Date: 1-8-16 Existing System Inspected by: Date:

Health Dept. Copy - WHITE Applicant (Final Approval) - YELLOW Applicant (Conditional Approval) - PINK