IREDELL COUNTY HEALTH DEPARTMENT

STATESVILLE 704-878-5305 MOORESVILLE 704-664-5281 (C1)

IMPROVEMENT PERMIT / AUTHORIZATION TO CONSTRUCT / OPERATION PERMIT / EXISTING SYSTEM INSPECTION

PERMIT# 1170 83 PIN# 4766-70-9131 DATE 12-31-03

OWNER OR CONTRACTOR JUNE TUTTERROW PHONE: Business 704-878-3103 Home 704-872-5926

ADDRESS 498 RIVER HILL RD STATESVILLE, NC 28625

LOCATION US 64 EAST, TL RIVER HILL ROAD, 1.6 MILES ON RIGHT AT BOX # 498

SUBDIVISION _____ BLOCK / SECTION _____ LOT _____ LOT AREA 1.72 ACRES SITE CLASS. PS DESIGN FLOW 600 L.T.A.R. EXISTING

Septic Tank: 1000 Gallons; STB _____ Date _____
Pump Tank: _____ Gallons; PT _____ Date _____
Pump Make: _____ Model _____ Serial No. _____
Nitrification Field: No Fields ____ Square Feet 675' Linear Feet 225'
No Lines 1 BED Trench Width _____ Max Trench Bottom Depth _____ Gravel Depth _____

☐ New System ☐ Repair System Type: I, (II), III, IV, V, VI
System Description: CONVENTIONAL, GRAVITY
Repair System Description: _____
Maintenance Agreement Required: ☐ Yes ☑ No


☑ House/Mod. Home No. Bedrooms 5
☐ Mobile Home No. Bathrooms ____
☐ Business No. Employees ____
☐ Other _____
☐ Slab ☐ Crawl Space ☑ Basement w/plumbing ☐ Basement wo/plumbing

Water Supply: ☑ Individual ☑ Public ☐ Community


Comments:/Conditions:

Comments:/Conditions: SYSTEM UNDERSIZED ACCORDING TO TODAY'S STANDARD

INITIAL SITE SKETCH

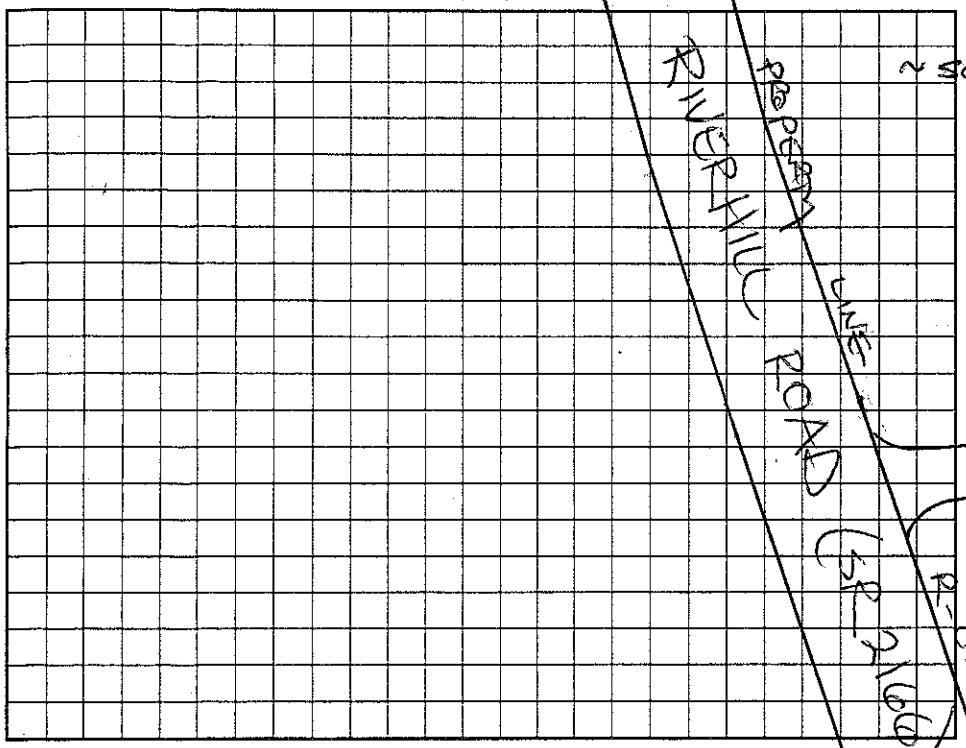

AS BUILT SKETCH

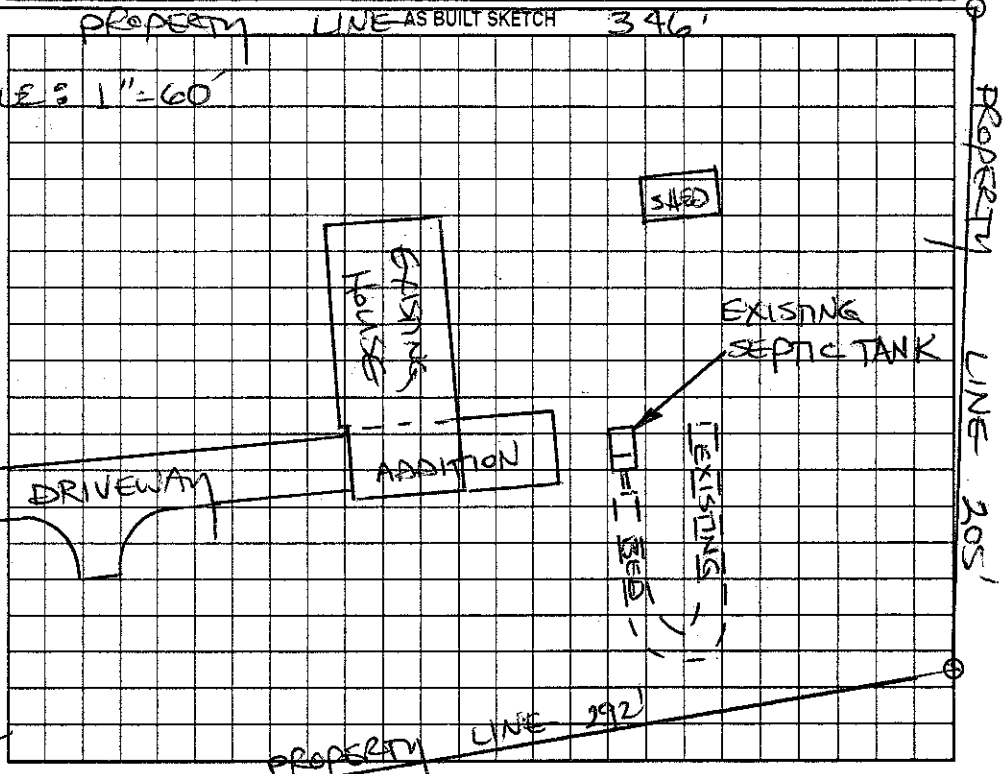

Permit can be suspended or revoked if any false information is supplied toward securing the permit, any unauthorized changes are made to the site, or any unauthorized changes are made in the installation of the system. Improvement Permit with plat valid without expiration. Improvement Permit with site plan valid for sixty months. Authorization to Construct is valid for a period equal to that of Improvement Permit – not to exceed sixty months.

Signed: _____ date _____

Improvement Permit by: _____ date _____

Authorization to Construct by: _____ date _____

Installed by: _____

Operation Permit by: _____ date _____

Existing System Inspection by: STEVE HEDRICK date 12-31-03

HEALTH DEPT. COPY: WHITE OWNER COPY (FINAL): YELLOW OWNER COPY (INITIAL): PINK