IREDELL COUNTY HEALTH DEPARTMENT

STATESVILLE 704-878-5305 MOORESVILLE 704-664-5281

IMPROVEMENT PERMIT / AUTHORIZATION TO CONSTRUCT / OPERATION PERMIT / EXISTING SYSTEM INSPECTION

PERMIT# 90369 PIN# 4766709429 DATE 7-10-00

OWNER OR CONTRACTOR Kimberly Ray PHONE: Business Home 878 2595

ADDRESS 511 Riverhill Rd Statesville

LOCATION US 64 East TL Riverhill Rd 2mi left beside 511 Riverhill Rd

SUBDIVISION BLOCK / SECTION LOT LOT AREA approx 2 acres SITE CLASS PS DESIGN FLOW 480 L.T.A.R. .4

Septic Tank: EX 1000 Gallons; STB Date

Pump Tank: Gallons; PT Date

Pump Make: Model Serial No.

Nitrification Field: No Fields Square Feet 600 Linear Feet 200

No Lines 2 Trench Width 36 " Max Trench Bottom Depth 36" Gravel Depth 12"

☐ New System ☐ Repair System Type: I (II) III. IV. V. VI

System Description:

Repair System Description: Conv. Gravity

Maintenance Agreement Required: ☐ Yes ☒ No

☐ House/Mod. Home ☒ Mobile Home ☐ Business ☐ Other

No. Bedrooms 4 No. Bathrooms 2 No. Employees

☐ Slab ☒ Crawl Space ☐ Basement w/plumbing ☐ Basement wo/plumbing


Water Supply: ☐ Individual ☒ Public ☐ Community

Comments:/Conditions:


[redacted] Replacing 4 Bedroom mH where 2 bedroom was placed.

Comments:/Conditions:

INITIAL SITE SKETCH

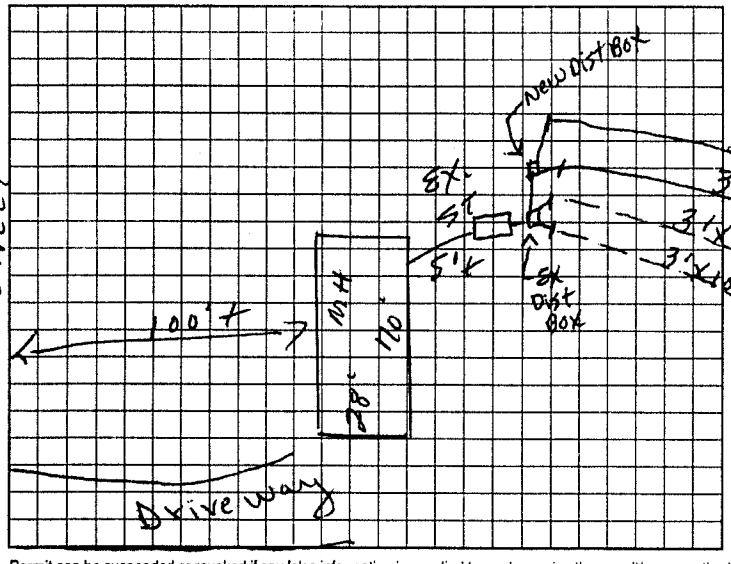

AS BUILT SKETCH

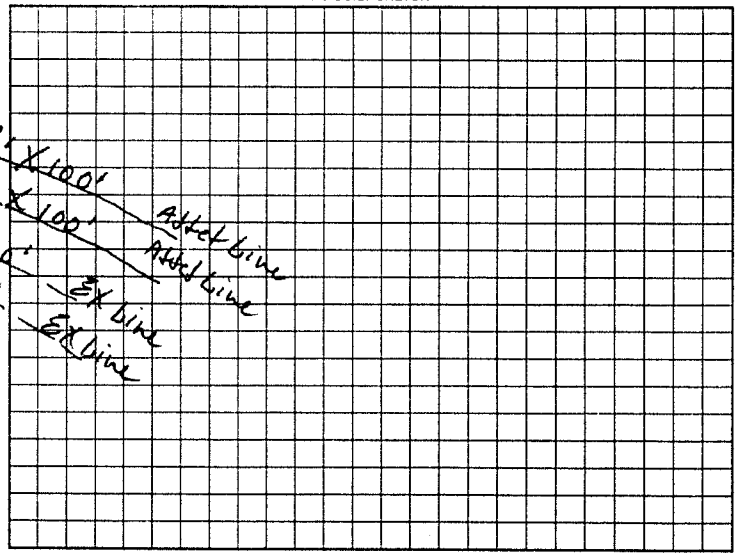

Permit can be suspended or revoked if any false information is supplied toward securing the permit/any unauthorized changes are made to the site/any unauthorized changes are made in the installation of the system. Improvement Permit with plat valid without expiration. Improvement Permit with site plan valid for ~~sixty~~ months. Authorization to Construct is valid for a period equal to that of Improvement Permit – not to exceed sixty months.

Signed: X Kimberly Hendrix Ray date 7-10-00 Installed by: Wes Lytton

Improvement Permit by: C. Moore date 7-10-00 Operation Permit by: [signature] date 10/31/00

Authorization to Construct by: C. Moore date 7-10-00 Existing System Inspection by: date

HEALTH DEPT. COPY: WHITE OWNER COPY (FINAL): YELLOW OWNER COPY (INITIAL): PINK