IREDELL COUNTY HEALTH DEPARTMENT

STATESVILLE 704-878-5305 MOORESVILLE 704-664-5281

IMPROVEMENT PERMIT / AUTHORIZATION TO CONSTRUCT / OPERATION PERMIT / EXISTING SYSTEM INSPECTION

PERMIT# 78343 PIN# 4766721238 DATE 12-29-98

OWNER OR CONTRACTOR Todd Ellis PHONE: Business 8086633 Home

ADDRESS LOCATION Meadow Oaks Chestnut Grove Rd To Seven Sp.

SUBDIVISION Seven Sp. BLOCK / SECTION LOT 32 LOT AREA 4.42 acres SITE CLASS P5 DESIGN FLOW 360 L.T.A.R. .25

Septic Tank: 1000 Gallons; STB 1012 Date 5-19-99

Pump Tank: Gallons; PT Date

Pump Make: Model Serial No.

Nitrification Field: No Fields 1 Square Feet 1440 Linear Feet 480

No Lines 4 Trench Width 36" Max Trench Bottom Depth 24" Gravel Depth 12"

☑ New System ☐ Repair System Type: ☐ II ☐ III ☐ IV ☐ V ☐ VI

System Description: Conv. Gravity

Repair System Description: " "

Maintenance Agreement Required: ☐ Yes ☐ No

☐ Slab ☐ Crawl Space ☐ Basement w/plumbing ☐ Basement wo/plumbing

☑ House/Mod. Home No. Bedrooms 3

☐ Mobile Home No. Bathrooms 2½

☐ Business No. Employees


☐ Other

Water Supply: ☐ Individual ☐ Public ☐ Community


Comments/Conditions: Shallow Soil Keep kitchen 24" To Trench bottom

Comments /Conditions

INITIAL SITE SKETCH

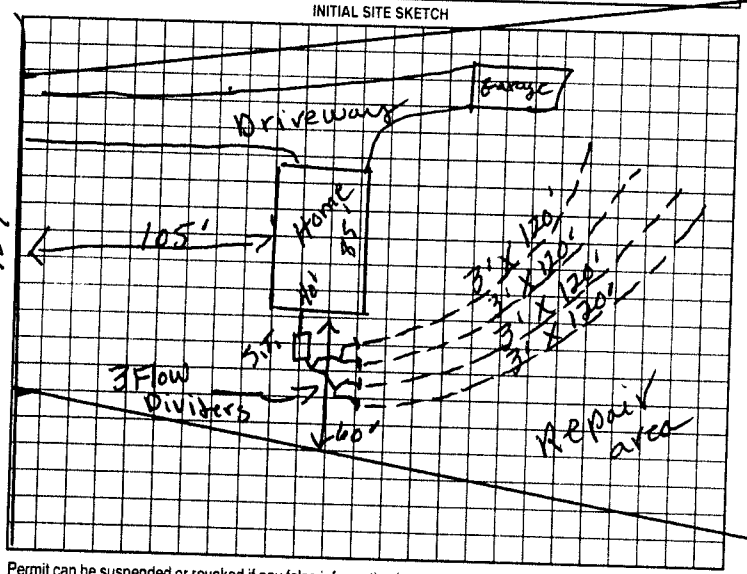

AS BUILT SKETCH

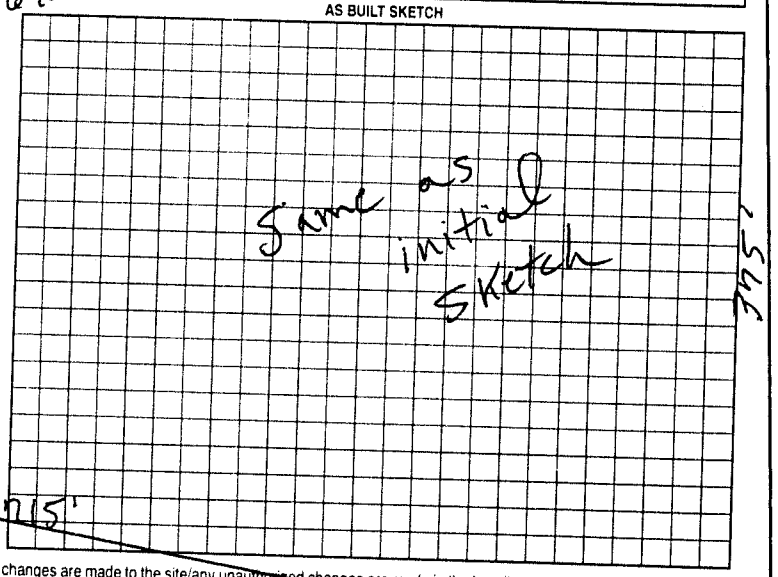

670'

Permit can be suspended or revoked if any false information is supplied toward securing the permit/any unauthorized changes are made to the site/any unauthorized changes are made in the installation of the system. Improvement Permit with plat valid without expiration, Improvement Permit with site plan valid for sixty months. Authorization to Construct is valid for a period equal to that of Improvement Permit - not to exceed sixty months.

Signed: Todd Ellis date 1-7-99 Installed by: David Yount

Improvement Permit by: P.C. Moore date 12-29-98 Operation Permit by: P.C. Moore date 7-22-99

Authorization to Construct by: P.C. Moore date 12-29-98 Existing System Inspection by: date

HEALTH DEPT COPY WHITE OWNER COPY (FINAL) YELLOW OWNER COPY (INITIAL) PINK