IRE[illegible] COUNTY HEALTH DEPARTMENT

STATESVILLE 704-878-5305 MOORESVILLE 704-664-5281

IMPROVEMENT PERMIT / AUTHORIZATION TO CONSTRUCT / OPERATION PERMIT / EXISTING SYSTEM INSPECTION

PERMIT# 97606 PIN# 4766724659 DATE 1-31-00

OWNER OR CONTRACTOR William Boan PHONE: Business _____ Home 881 0521

ADDRESS 415 East Broad St. Statesville, N.C.

LOCATION old mocksville TR chestnut Grove TR 1st Entervance to 17 springs 1/2 mi left

SUBDIVISION Seven Springs BLOCK / SECTION _____ LOT 74 LOT AREA 1.14 acres SITE CLASS PS DESIGN FLOW 480 L.T.A.R. .33

Septic Tank: 1000 Gallons; STB 10/12 TP Date 8-15-00
Pump Tank: _____ Gallons; PT _____ Date _____
Pump Make: _____ Model _____ Serial No. _____
Nitrification Field: No Fields 1 Square Feet 1380 Linear Feet 460
No Lines 5 Trench Width 36" Max Trench Bottom Depth 36" Gravel Depth 12"

☐ New System ☐ Repair System Type: I, II, III, IV, V, VI
System Description: conv. Gravity
Repair System Description: Pump To 25% Reduct.
Maintenance Agreement Required: ☐ Yes ☐ No
☐ Slab ☐ Crawl Space ☐ Basement w/plumbing ☐ Basement wo/plumbing


☐ House/Mod. Home No. Bedrooms 4
☐ Mobile Home No. Bathrooms 2 1/2
☐ Business No. Employees _____
☐ Other _____

Water Supply:
☐ Individual
☐ Public
☐ Community


Comments/Conditions:

Comments/Conditions:

INITIAL SITE SKETCH

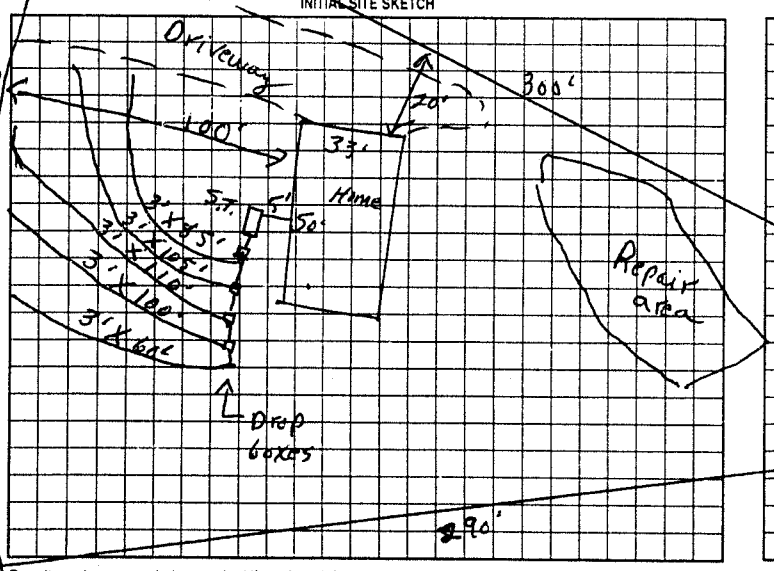

AS BUILT SKETCH

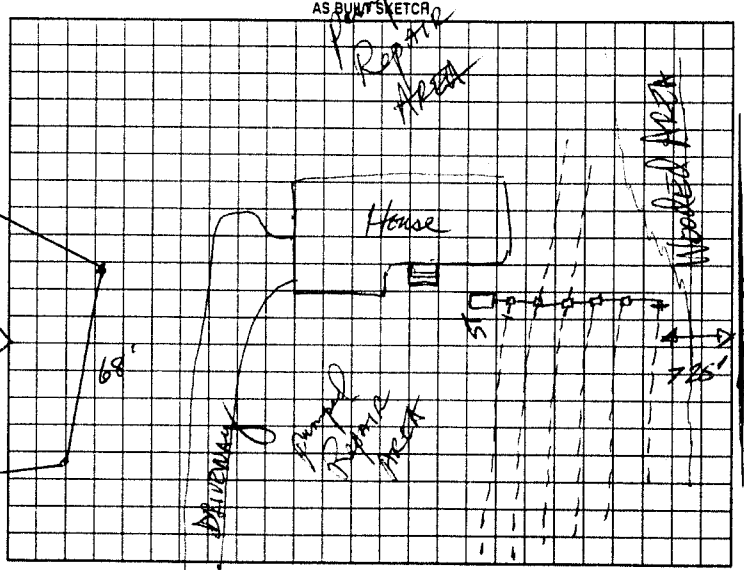

Permit can be suspended or revoked if any false information is supplied toward securing the permit/any unauthorized changes are made to the site/any unauthorized changes are made in the installation of the system. Improvement Permit with plat valid without expiration. Improvement Permit with site plan valid for sixty months. Authorization to Construct is valid for a period equal to that of Improvement Permit – not to exceed sixty months.

Signed: William D. Boan date 2-24-00 Installed by: Kelly Blank

Improvement Permit by: D. C. Moore date 1-31-00 Operation Permit by: [illegible] date 10-13-00

Authorization to Construct by: D. C. Moore date 1-31-00 Existing System Inspection by: _____ date _____

HEALTH DEPT. COPY: WHITE OWNER COPY (FINAL): YELLOW OWNER COPY (INITIAL): PINK