IREDELL COUNTY HEALTH DEPARTMENT

STATESVILLE 704-878-5305 MOORESVILLE 704-664-5281

IMPROVEMENT PERMIT / AUTHORIZATION TO CONSTRUCT / OPERATION PERMIT / EXISTING SYSTEM INSPECTION

PERMIT# 078199 PIN# 4766 72 6973 DATE 12-22-98

OWNER OR CONTRACTOR ROBERT COOK PHONE: Business Home 924-7209

ADDRESS 609 FOX CROFT TERRACE APT B-4, STATESVILLE, NC 28677

LOCATION OLD MOCKSVILLE ROAD NE, TR CHESTNUT GROVE RD, TR 2ND SEVEN SPRING LOOP ENTRANCE, LOT ON RIGHT AT 1ST CURVE

SUBDIVISION SEVEN SPRINGS BLOCK / SECTION LOT 82 LOT AREA 1.1023 ACRES SITE CLASS. PS DESIGN FLOW 360 L.T.A.R. 0.30 ADD AT 2

Septic Tank: 1000 Gallons; STB 1012 Date 5-24-99
Pump Tank: Gallons; PT Date
Pump Make: Model Serial No.
Nitrification Field: No. Fields 1 Square Feet 1200 Linear Feet 400
No Lines FOUR Trench Width 36" Max Trench Bottom Depth 36" Gravel Depth 12"

[X] New System [ ] Repair System Type: I, II, III, IV, V, VI
System Description: CONVENTIONAL GRAVITY
Repair System Description: CONV. GRAVITY
Maintenance Agreement Required: [ ] Yes [X] No
[ ] Slab [X] Crawl Space [X] Basement w/plumbing [ ] Basement wo/plumbing


[X] House/Mod. Home No. Bedrooms 3
[ ] Mobile Home No. Bathrooms 3
[ ] Business No. Employees
[ ] Other

Water Supply: [ ] Individual [X] Public [ ] Community


Comments:/Conditions: INSTALL SYSTEM AS FLAGGED ON SITE @ INSTALL LINES ON CONTOUR, NO DEEPER THAN 36"

Comments:/Conditions:

INITIAL SITE SKETCH SCALE: 1" = 50'

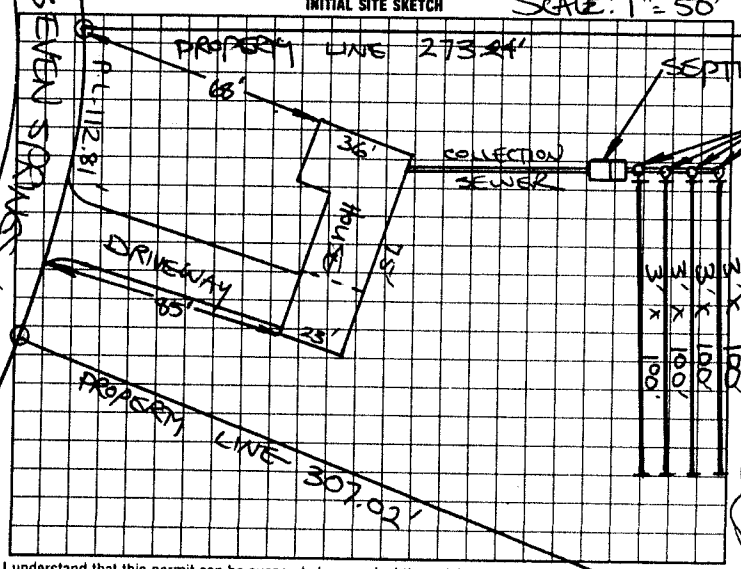

AS BUILT SKETCH

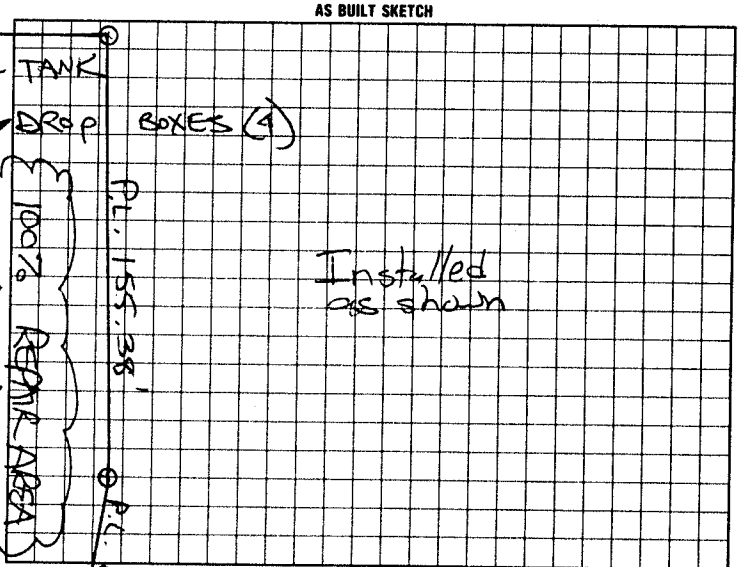

I understand that this permit can be suspended or revoked if any false information is supplied toward securing the permit/any unauthorized changes are made to the site/any unauthorized changes are made in the installation of the system. Improvement Permit with plat valid without expiration. Improvement Permit with site plan valid for sixty months. Authorization to Construct is valid for a period equal to that of Improvement Permit – not to exceed sixty months.

Signed: Robert L. Cook date 12/22/98 Installed by: Tommy Tayne

Improvement Permit by: STEVE HEDRICK date 12-22-98 Operation Permit by: 9M4 COA 125 date 7-30-99

Authorization to Construct by: STEVE HEDRICK date 12-22-98 Existing System Inspection by: date

HEALTH DEPT. COPY: WHITE INSPECTION COPY (FINAL): GREEN OWNER COPY (FINAL): YELLOW INSPECTION COPY (INITIAL): PINK OWNER COPY (INITIAL): GOLD