IREDELL COUNTY HEALTH DEPARTMENT

STATESVILLE 704-878-5305 MOORESVILLE 704-664-5281

IMPROVEMENT PERMIT / AUTHORIZATION TO CONSTRUCT / OPERATION PERMIT / EXISTING SYSTEM INSPECTION

PERMIT# 78931 PIN# 4766729108 DATE 1-20-99

OWNER OR CONTRACTOR Kenneth Wilcox PHONE: Business _____ Home _____

ADDRESS 193 Dunlap Loop

LOCATION Off Mocksville TR Chestnut Grove TR Seven Sp. 1/2mi [redacted] left

SUBDIVISION Seven Sp. LP. BLOCK / SECTION _____ LOT 28 LOT AREA 2.41 acres SITE CLASS PS DESIGN FLOW 360 L.T.A.R. .3

Septic Tank: 1000 Gallons; STB 1012 Date 7-6-99
Pump Tank: _____ Gallons; PT _____ Date _____
Pump Make: _____ Model _____ Serial No. _____
Nitrification Field: No Fields 1 Square Feet 1200 Linear Feet 400
No Lines 4 Trench Width 36" Max Trench Bottom Depth 36" Gravel Depth 12"

☑ New System ☐ Repair System Type: ☐ I ☐ II ☐ III ☐ IV ☐ V ☐ VI
System Description: Conv. Gravity
Repair System Description: " "
Maintenance Agreement Required: ☐ Yes ☑ No
☐ Slab ☑ Crawl Space ☐ Basement w/plumbing ☐ Basement wo/plumbing

☑ House/Mod. Home No. Bedrooms 3
☐ Mobile Home No. Bathrooms 2½
☐ Business No. Employees _____
☐ Other _____


Water Supply: ☐ Individual ☑ Public ☐ Community

Comments/Conditions:


Comments/Conditions

571'

INITIAL SITE SKETCH

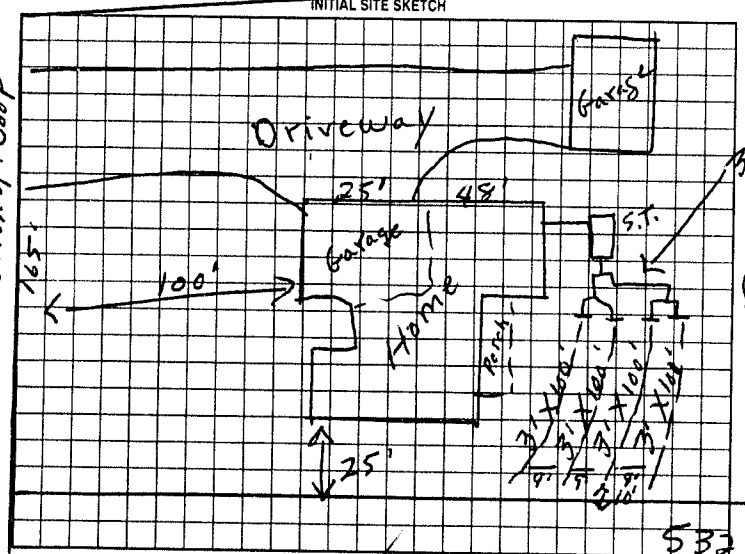

AS BUILT SKETCH

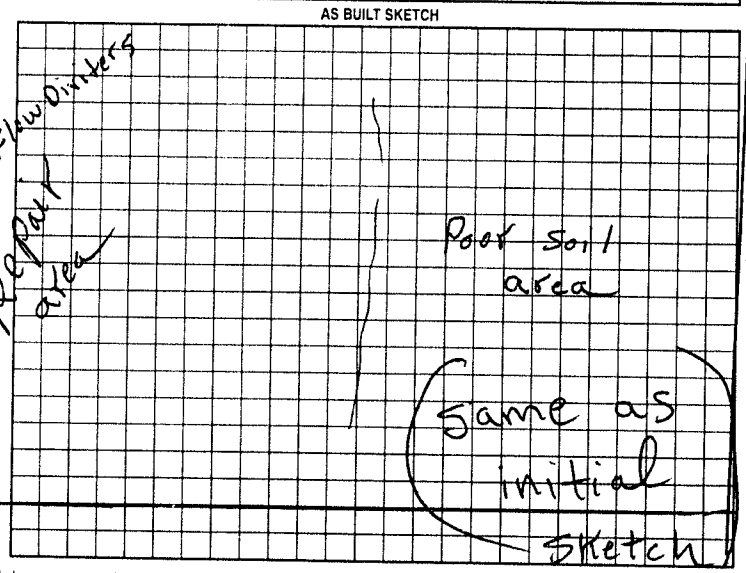

Permit can be suspended or revoked if any false information is supplied toward securing the permit/any unauthorized changes are made to the site/any unauthorized changes are made in the installation of the system. Improvement Permit with plat valid without expiration. Improvement Permit with site plan valid for sixty months. Authorization to Construct is valid for a period equal to that of Improvement Permit -- not to exceed sixty months.

Signed: X. _____ date _____ Installed by: David Yountz

Improvement Permit by: P.C. moore date 1-20-99 Operation Permit by: P.C. moore date 8-8-99

Authorization to Construct by: P.C. moore date 1-20-99 Existing System Inspection by: _____ date _____

HEALTH DEPT COPY: WHITE OWNER COPY (FINAL): YELLOW OWNER COPY (INITIAL): PINK