IREDELL COUNTY HEALTH DEPARTMENT

STATESVILLE 704-878-5305 MOORESVILLE 704-664-5281

IMPROVEMENT PERMIT / AUTHORIZATION TO CONSTRUCT / OPERATION PERMIT / EXISTING SYSTEM INSPECTION

PERMIT# 88951 PIN# 4766729886 DATE 5/9/00

OWNER OR CONTRACTOR TODD ELLIS PHONE: Business 878-6633 Home

ADDRESS 315 SEVEN SPRINGS LOOP STATESVILLE NC 28625

LOCATION OLD MOCKSVILLE - TR CHESTNUT GROVE - 2ND SPRINGS LOOP ON RT

SUBDIVISION SEVEN SPRINGS BLOCK / SECTION LOT 80 LOT AREA .86AC SITE CLASS PS DESIGN FLOW 360GPD L.T.A.R. .3 gpd/ft²

Septic Tank: 1000 Gallons: STB 1012 Date 7-3-01

Pump Tank: Gallons: PT Date

Pump Make: Model Serial No.

Nitrification Field: No Fields 1 Square Feet 1200 Linear Feet 400

No Lines 4@100' Trench Width 36" Max Trench Bottom Depth 36" Gravel Depth 12"

☑ New System ☐ Repair System Type: I II III IV V VI

System Description: GRAVITY CONVENTIONAL

Repair System Description: GRAV/PUMP INNOVATIVE

Maintenance Agreement Required: ☐ Yes ☑ No

☑ House/Mod. Home No. Bedrooms 3

☐ Mobile Home No. Bathrooms 2

☐ Business No. Employees

☐ Other


☐ Slab ☑ Crawl Space ☐ Basement w/plumbing ☐ Basement wo/plumbing

Water Supply: ☐ Individual ☑ Public ☐ Community


Comments/Conditions: 1) PLUMBING TO BE STUBBED OUT HIGH TO ACHIEVE GRAVITY FLOW

Comments/Conditions: SEPTIC TANK WITH RISERS INSTALLED USING "POLYLOK" FILTER

INITIAL SITE SKETCH 1"=50'

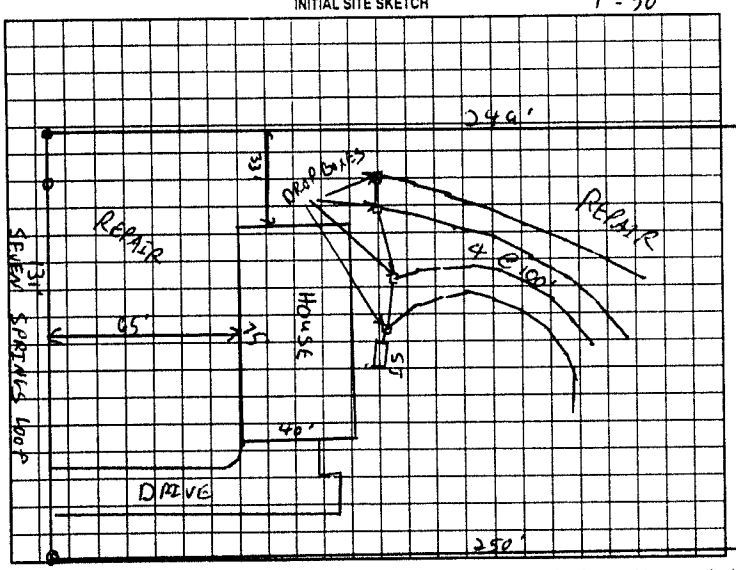

AS BUILT SKETCH

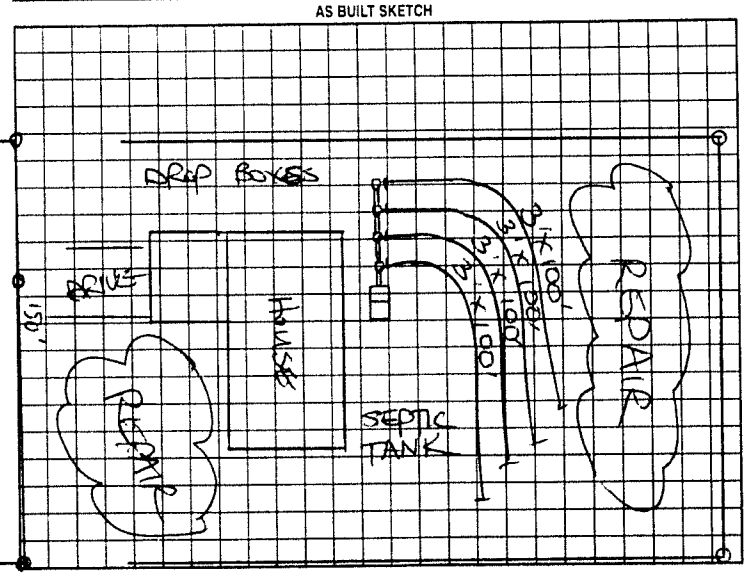

Permit can be suspended or revoked if any false information is supplied toward securing the permit/any unauthorized changes are made to the site/any unauthorized changes are made in the installation of the system. Improvement Permit with plat valid without expiration. Improvement Permit with site plan valid for sixty months. Authorization to Construct is valid for a period equal to that of Improvement Permit – not to exceed sixty months.

Signed: date 5/9/00 Installed by: DAVID YOUNTS

Improvement Permit by: C. Hyatt RS date 5/9/00 Operation Permit by: STEVE HEDRICK date 9-28-01

Authorization to Construct by: C. Hyatt RS date 5/9/00 Existing System Inspection by: date

HEALTH DEPT. COPY: WHITE OWNER COPY (FINAL): YELLOW OWNER COPY (INITIAL): PINK