IREDELL COUNTY HEALTH DEPARTMENT

Statesville Office (704) 878-5305 Mooresville Office (704) 660-3625

IMPROVEMENT PERMIT / AUTHORIZATION TO CONSTRUCT / OPERATION PERMIT / EXISTING SYSTEM

PERMIT # 219700. 2:00

PIN # 4766-73-0301

APPLICANT: Robert Crosswhite

APPLICANT ADDRESS: 353 Seven Springs LP Sta NC

SITE ADDRESS: 343 Seven Springs Cir Statesville NC

PHONE: 704-437-037 ALT. PHONE:

SITE DIRECTIONS 90 Mocksville Rd, To Chestnut Grove Rd., TR Seven Springs LP, Site on R

SUBDIVISION: Seven Springs


SECTION: LOT # 37+38 LOT AREA:

DESIGN FLOW: 240 GPD L.T.A.R.: .3


Septic Tank	1000 (gal)	STB	158	Date	In Bitrator	☑ New System ☐ Repair ☐ Expansion	System Type: I II III IV V VI	☑ Residence	No. Bedrooms	2	Water Supply
Pump Tank	(gal)	PT		Date		System Description: 25% Reduction - Gravity		☐ Business	No. Persons	4	☐ Private
Pump Make		Model		Serial #		Repair System Description: 25% Reduction - Gravity w/ Curtain		☐ Other	No. Employees		☑ Public
# Nitrification Fields	1	# Lines	4 @ 50'	Linear Ft:	200'	Maintenance Agreement Required:	☐ YES ☒ NO	☑ Slab	☐ Crawl Space		☐ Community
Trench Width	36"	Max. Trench Bottom Depth	*26"*	Gravel Depth	N/A	☑ GRAVITY	☐ PRESSURE	☐ Basement w/plumbing		☐ Basement w/o plumbing	

Comments / Conditions: Maintain 20' from Existing 4 BR System. LE Repair is utilized for 2 BR System, Additional Cover will be Required. This Permit is for Proposed 1 BR Apartment And Garage. Follow All NC Septic Rules & Regs. * Lot 37 & 38 Must Be Combined And Recorded Prior To Issuance of AC. *

INITIAL SITE SKETCH

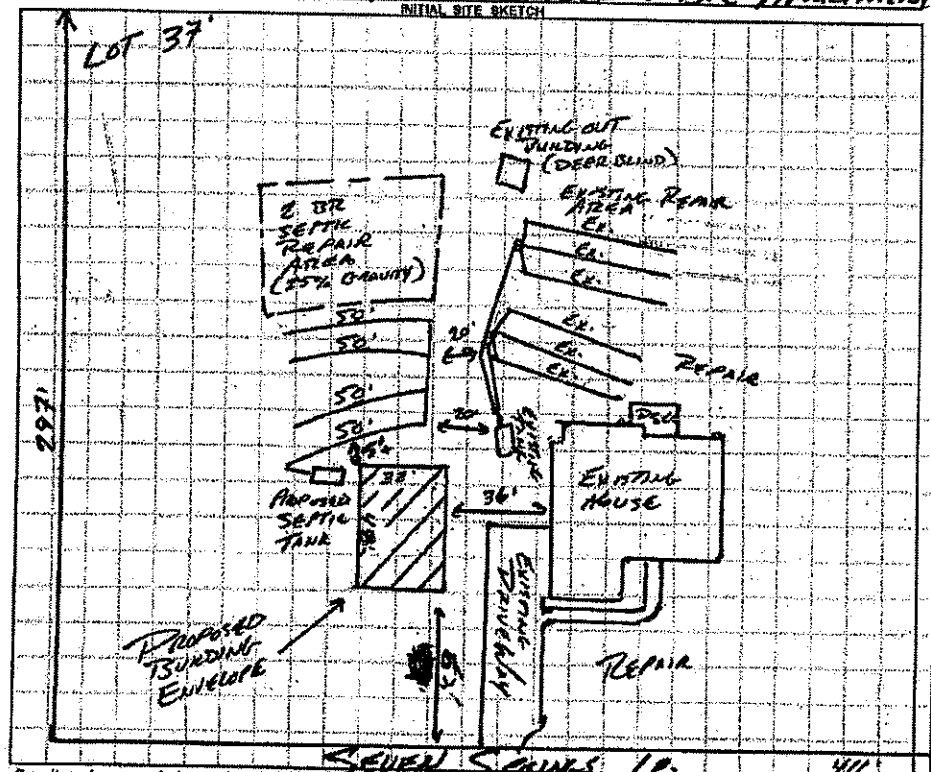

AS BUILT SKETCH

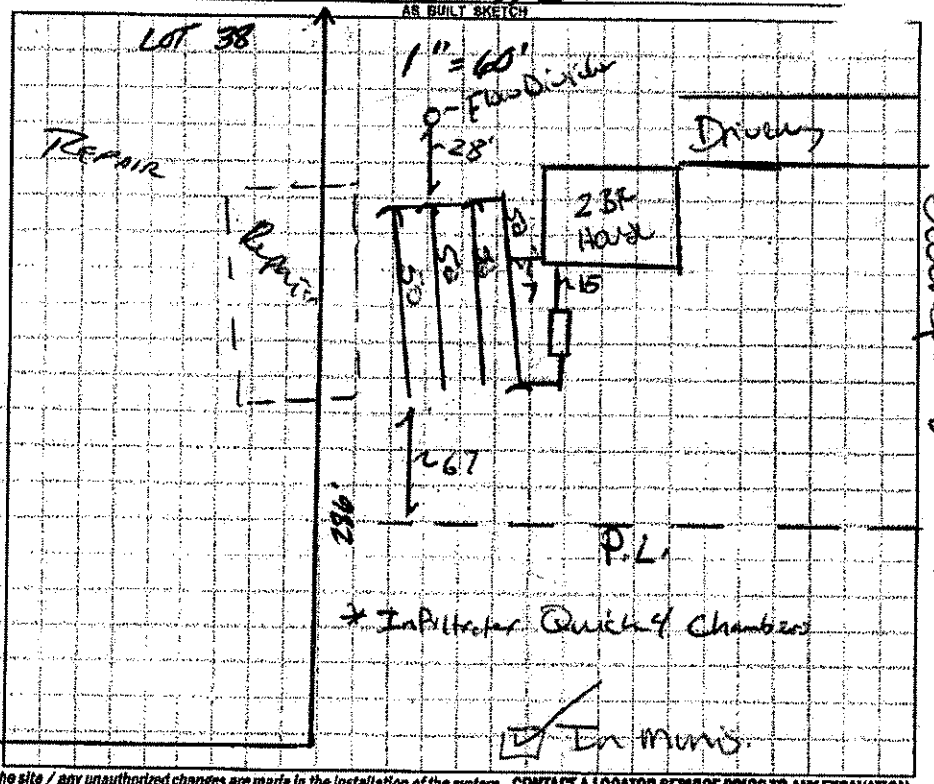

Permit can be suspended or revoked if any false information is supplied toward securing the permit / any unauthorized changes are made to the site / any unauthorized changes are made in the installation of the system. CONTACT A LOCATOR SERVICE PRIOR TO ANY EXCAVATION

☐ IMPROVEMENT PERMIT with plat valid without expiration ☑ IMPROVEMENT PERMIT with site plan valid for 60 mos. ☒ AUTHORIZATION TO CONSTRUCT valid for period equal to IMPROVEMENT PERMIT--not to exceed 60 mo.

Owner / Applicant Signature: Date: Installed by: David Vantz

IMPROVEMENT PERMIT by: APPROVED AUG 03 2016 OPERATION PERMIT by: B. Bottling Date: 3/21/2017

AUTHORIZATION TO CONSTRUCT by: Date: 09/14/16 Existing System Inspected by: Date:

Health Dept. Copy - WHITE Applicant (Final Approval) - YELLOW Applicant (Conditional Approval) - PINK