IREDELL COUNTY HEALTH DEPARTMENT


ENVIRONMENTAL HEALTH DIVISION

PAGE 2: *SITE PLAN WORKSHEET*

SEE THE "SAMPLE SITE PLAN" BELOW. *INCOMPLETE SITE PLANS WILL BE RETURNED TO YOU FOR COMPLETION AND MAY RESULT IN A DELAY IN THE ISSUANCE OF YOUR SEPTIC SYSTEM PERMIT!!!*

Place an (X) beside each item as you complete the site plan:

( ) Property Line measurements are clearly identified
( ) All proposed structures are indicated
( ) Front and side setbacks from property line
( ) Preferred driveway location and well location
( ) Area you prefer your septic system to be placed
( ) North arrow, or other sufficient indicator of direction

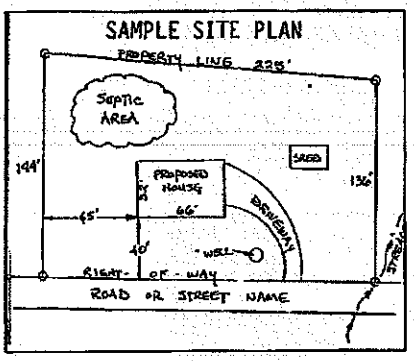


Circle N/A on the following if appropriate:

Location of septic systems and wells within 100' of your property	N/A
Location of easements and rights of ways on your property	N/A
Location of any designated wetlands on the property	N/A

USE THIS SPACE TO DRAW YOUR SITE PLAN

Show: proposed house or business footprint, wells, water lines, patios, pools and decks, and any other item that will occupy space on the site

will combine Lot 57236 to lot.

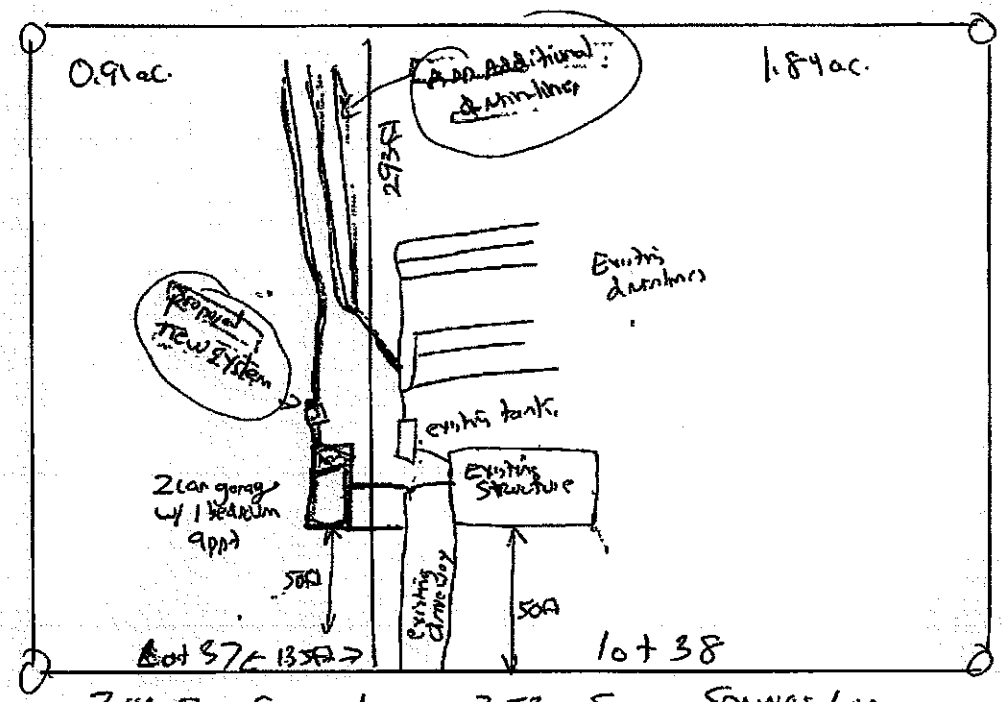


343 Seven Springs Loop 353 Seven Springs Loop

(Seven Springs)

Signature: _____ 6-20-16

Property owner or owner's legal representative signature (SIGNATURE REQUIRED) — DATE

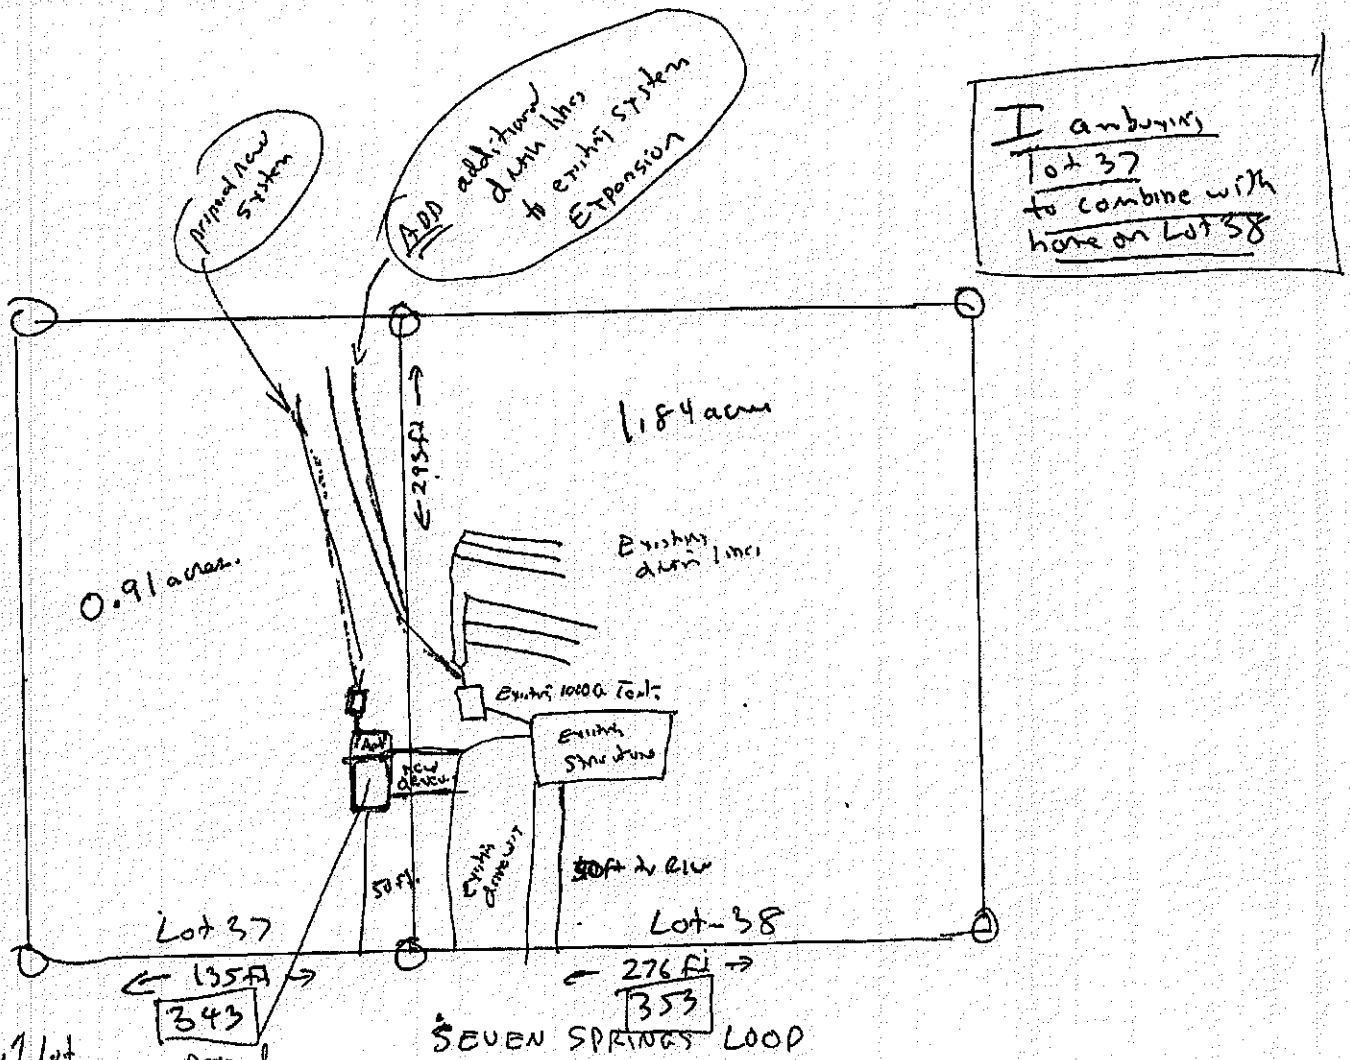

- Will combine lots to 1 lot
- 1 residence w/ mother in law (1 bed 500 sqft appt.

IREDELL COUNTY HEALTH DEPARTMENT

THIS PERMIT VOIDS PREVIOUS ISSUED 2-6-03

STATESVILLE 704-878-5305 MOORESVILLE 704-664-5281

IMPROVEMENT PERMIT / AUTHORIZATION TO CONSTRUCT / OPERATION PERMIT / EXISTING SYSTEM INSPECTION

PERMIT# 107722 PIN# 4766-63-9397 DATE 11-24-03

OWNER OR CONTRACTOR ROBERT CROSSWHITE PHONE Business (704) 873 7233 Home 704-585-9805

ADDRESS 130 WESTSCOTT DR STATESVILLE NC 28625

LOCATION OLD MOCKSVILLE RD, TL CHESTNUT GROVE ROAD, TR 1ST SEVEN SPRINGS LOOP, LOT ON R (LEFT)

SUBDIVISION SEVEN SPRINGS BLOCK / SECTION ____ LOT 38 LOT AREA 1.8376 SITE CLASS PS DESIGN FLOW 480 L.T A.R 0.30 (AA)/PR2

Septic Tank: 1000 Gallons, STB ____ Date ____

Pump Tank: ____ Gallons; PT ____ Date ____

Pump Make: ____ Model ____ Serial No. ____

Nitrification Field: No Fields 1 Square Feet 1600 Linear Feet 270

No Lines SIX Trench Width 24" Max Trench Bottom Depth 36"

☒ New System ☐ Repair System Type: I, II, III, IV, V

System Description: 50% REDUCTION, GRAVITY

Repair System Description: 50% REDUCTION, LOW PRESSURE

Maintenance Agreement Required: ☐ Yes ☒ No

Gravel Depth SAND 24" ☐ Slab ☑ Crawl Space ☐ Basement w/plumbing ☐ Basement wo/plumbing

☒ House/Mod. Home No. Bedrooms 4

☐ Mobile Home No Bathrooms 2

☐ Business No Employees ____


☐ Other ____

Water Supply: ☐ Individual ☒ Public ☐ Community

Comments/Conditions: INSTALL 50% REDUCTION SYSTEM USING SIXTY-SIX (66) PPBPS PANELS. USE ONE FLOW DIVIDER TEE AND TWO "TRU-FLOW" SPLITTERS TO ACHIEVE EQUAL DIST.

Comments/Conditions:

INITIAL SITE SKETCH

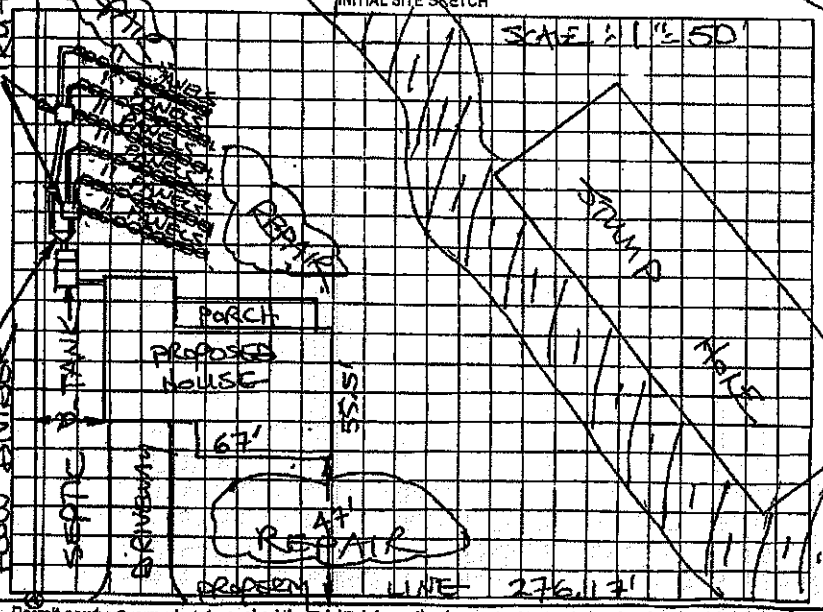

AS BUILT SKETCH

Permit can be suspended or revoked if any false information is supplied toward securing the permit/any unauthorized changes are made to the site/any unauthorized changes are made in the installation of the system. Improvement Permit with plat valid without expiration. Improvement Permit with site plan valid for sixty months. Authorization to Construct is valid for a period equal to that of Improvement Permit – not to exceed sixty months.

Signed: ____ date 11-25-03 Installed by: ____

Improvement Permit by: STEVE HEDRICK date 11-24-03 Operation Permit by: ____ date ____

Authorization to Construct by: STEVE HEDRICK date 11-24-03 Existing System Inspection by: ____ date ____

HEALTH DEPT COPY WHITE OWNER COPY (FINAL): YELLOW OWNER COPY (INITIAL) PINK

IREDELL COUNTY HEALTH DEPARTMENT

THIS PERMIT VOIDS PREVIOUS ISSUED 2-6-03

STATESVILLE 704-878-5305 MOORESVILLE 704-664-5281

IMPROVEMENT PERMIT / AUTHORIZATION TO CONSTRUCT / OPERATION PERMIT / EXISTING SYSTEM INSPECTION

PERMIT# 107722 PIN# 4766-63-9397 DATE 11-24-03

OWNER OR CONTRACTOR ROBERT CROSSWHITE PHONE: Business (704) 873-7233 Home 704-585-9808

ADDRESS 130 WESTSCOTT DR STATESVILLE NC 28625

LOCATION OLD MOCKSVILLE RD TR CHESTNUT GROVE ROAD @, TR 1ST SEVEN SPRINGS LOOP, LOT ON RIGHT

SUBDIVISION SEVEN SPRINGS BLOCK / SECTION 1 LOT 38 LOT AREA 1.8376 SITE CLASS PS DESIGN FLOW 480 L.T.A.R. 0.30 GPD/FT²

Septic Tank: 1000 Gallons: STB 825 Date 4-9-04

Pump Tank: Gallons: PT Date

Pump Make: Model Serial No.

Nitrification Field: No Fields 1 Square Feet 1600 Linear Feet 270

No Lines SIX Trench Width 24" Max Trench Bottom Depth 36"

☑ New System ☐ Repair System Type: I, II, III, IV, V, VI

System Description: 50% REDUCTION, GRAVITY

Repair System Description: 50% REDUCTION, CONV

Maintenance Agreement Required: ☐ Yes ☑ No PRESSURE

Gravel Depth SAND 24" ☐ Slab ☑ Crawl Space ☐ Basement w/plumbing ☐ Basement wo/plumbing

☑ House/Mod. Home No. Bedrooms 4

☐ Mobile Home No. Bathrooms 2


☐ Business No. Employees

☐ Other

Water Supply: ☐ Individual ☑ Public ☐ Community


Comments/Conditions: INSTALL 50% REDUCTION SYSTEM USING SIXTY-SIX (66) PPBRS PANELS. USE ONE-FLOW DIVIDER TEE AND TWO "TRU-FLOW" SPLITTERS TO ACHIEVE EQUAL DIST.

INITIAL SITE SKETCH

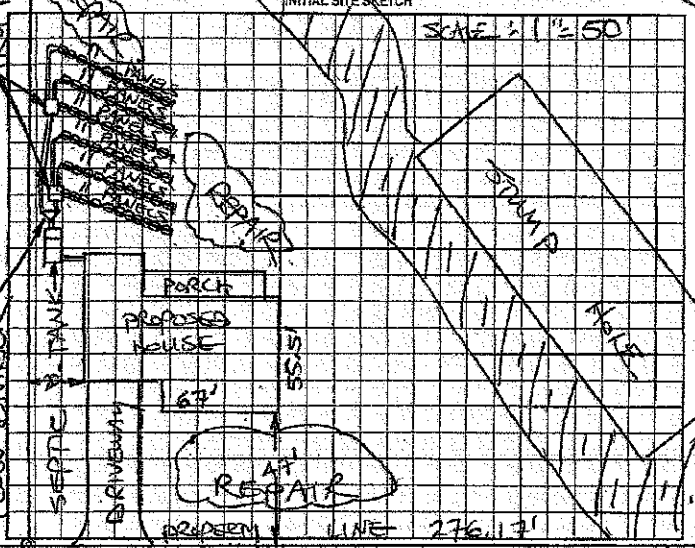

Comments/Conditions: SEPTIC TANK W/ POLYLOK FILTER INSTALLED
(2) FLOW DIVIDER UPPER "TRU-FLOW" SPLITTER
(3) UPPER 4 LINES INSPECTED 6-18-04 - OK
(4) LOWER 2 LINES + "HOUSE" TRU-FLOW SPLITTER OK 6/23/04 BS

AS BUILT SKETCH

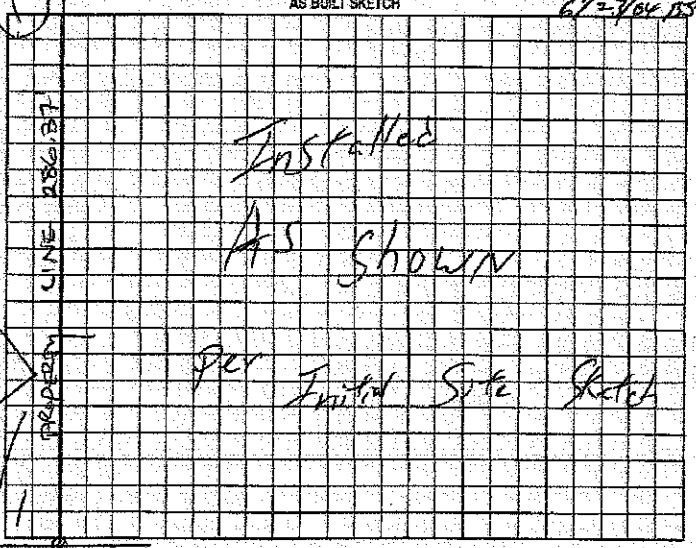

Permit can be suspended or revoked if any false information is supplied toward securing the permit, any unauthorized changes are made to the site, any unauthorized changes are made in the installation of the system. Improvement Permit with plat valid without expiration. Improvement Permit with site plan valid for sixty months. Authorization to Construct is valid for a period equal to that of Improvement Permit – not to exceed sixty months.

Signed: _____ date 11-25-03 Installed by: MULLETT BUILDERS

Improvement Permit by: STEVE HEDRICK date 11-24-03 Operation Permit by: _____ date 6/23/04

Authorization to Construct by: STEVE HEDRICK date 11-24-03 Existing System Inspection by: _____ date _____

HEALTH DEPT. COPY: WHITE OWNER COPY (FINAL): YELLOW OWNER COPY (INITIAL): PINK