IREDELL COUNTY HEALTH DEPARTMENT

STATESVILLE 704-878-5305 MOORESVILLE 7(

IMPROVEMENT PERMIT / AUTHORIZATION TO CONSTRUCT / OPERATION PERMIT / EXISTING SY

PERMIT# 11961 PIN# 4766-73-0519

OWNER OR CONTRACTOR JEFFREY TODD ECCLS PHONE: Business 704-902-0119 Home 704

ADDRESS 315 SEVEN SPRINGS LOOP, STATESVILLE NC 28677

LOCATION OLD MOCKSVILLE ROAD NE, TR CHESTNUT GROVE RD, TR 1ST SEVEN SPRINGS

SUBDIVISION SEVEN SPRINGS BLOCK / SECTION LOT 34 LOT AREA 1.1092 ACRE SITE CLASS. PS DESIGN FLOW 360

Septic Tank: 1000 Gallons; STB 1012 Date 1-22-04

Pump Tank: Gallons; PT Date

Pump Make: Model Serial No.

Nitrification Field: No Fields 1 Square Feet EQ. TO 1200 Linear Feet 300

No Lines FIVE Trench Width 36" Max Trench Bottom Depth 36 Gravel Depth N/A

☑ New System ☐ Repair System Type: I, II, (III), IV, V, VI

System Description: 25% REDUCTION GRAVITY

Repair System Description: 25% REDUCTION, GRAVITY

Maintenance Agreement Required: ☐ Yes ☑ No

☑ House/Mod. Home No.

☐ Mobile Home No.

☐ Business No.


☐ Other

☐ Slab ☑ Crawl Space ☐ Basement w/plumbing ☑ Basen

Comments:/Conditions: INSTALL 25% REDUCTION SYSTEM

Comments:/Conditions: SEPTIC TANK WITH M
USING "TUFFITE" FIL

INITIAL SITE SKETCH SCALE: 1"=50'

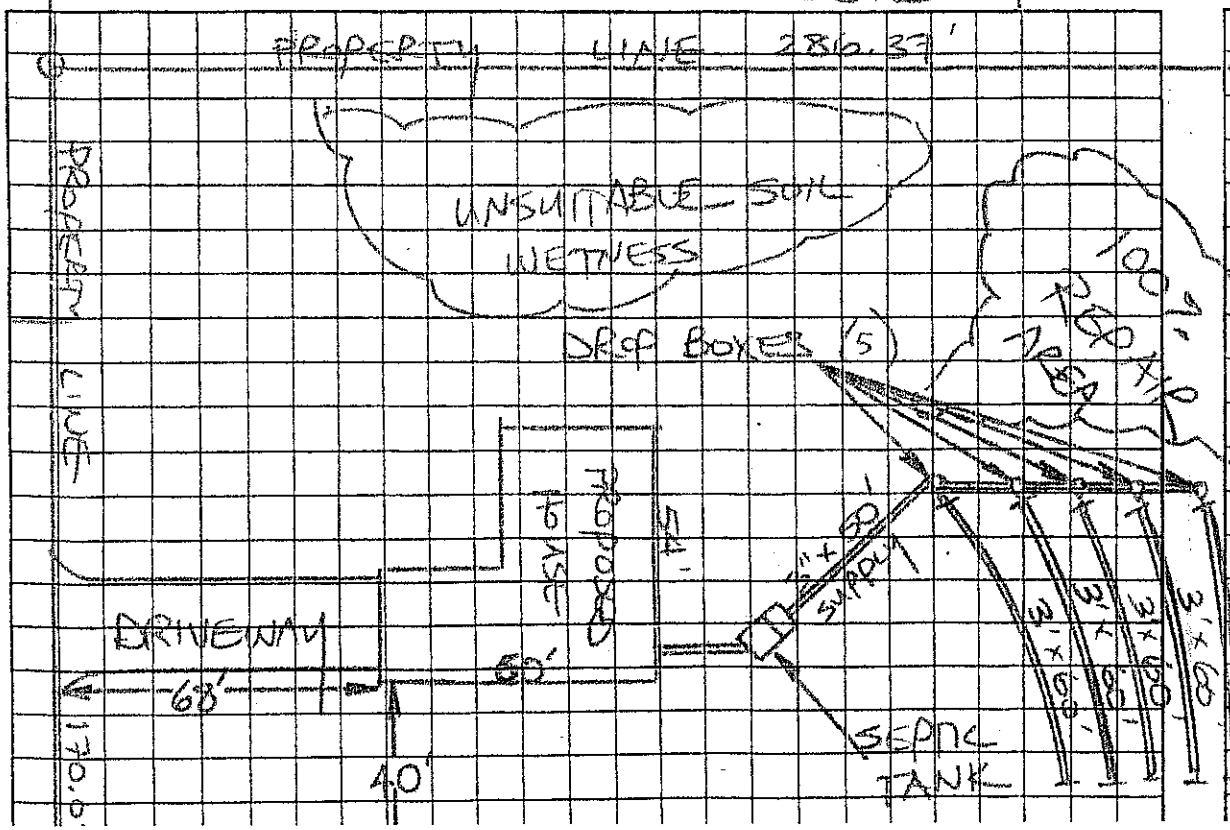

AS BUILT SKETCH

SYSTEM INSTA
ACCORDING TO L
SITE SKETCH U
60" INFILTRATOR