# IREDELL COUNTY HEALTH DEPARTMENT

Statesville Office (704) 878-5305 Mooresville Office (704) 660-3625 PERMIT # 216469

## IMPROVEMENT PERMIT / AUTHORIZATION TO CONSTRUCT / OPERATION PERMIT / EXISTING SYSTEM

PIN # 4766730716

APPLICANT: Theresa Martin APPLICANT ADDRESS: 312 Seven Springs Lp

SITE ADDRESS: 371 Seven Springs Lp PHONE: 931-237-8619 ALT. PHONE: N/A

SITE DIRECTIONS: Hwy 64 E TL old Mocksville Rd TR Chestnut Grove Rd, TR Seven Springs Lp


SUBDIVISION: Seven Springs SECTION: 1 LOT # 40 LOT AREA: 0.97 acres DESIGN FLOW: 360gpd L.T.A.R.: 0.3

| | | | | | | | | | |
|---|---|---|---|---|---|---|---|---|---|
| Septic Tank | 1000 (gal) | STB | New | Date | 3-6-16 | ☑ New System ☐ Repair ☐ Expansion | System Type: I II (III) IV V VI | ☑ Residence | No. Bedrooms 3 |
| Pump Tank | N/A (gal) | PT | N/A | Date | N/A | System Description: | 25% Reduction | ☐ Business | No. Persons 6 |
| Pump Make | N/A | Model | Polylok | Serial # | PL-68 | Repair System Description: | 25% Reduction | ☐ Other | No. Employees |
| # Nitrification Fields | 1 | # Lines | 4 | Linear Ft: | 300 | Maintenance Agreement Required: | ☐ YES ☑ NO | ☐ Slab | ☑ Crawl Space |
| Trench Width | 36" | Max. Trench Bottom Depth | 36" | Gravel Depth | N/A | ☐ GRAVITY ☐ PRESSURE | | ☐ Basement w/plumbing | ☐ Basement w/o plumbing |


Water Supply: ☐ Private ☑ Public ☐ Community

Comments / Conditions: Install a 25% Reduction system on contour with serial distribution.

INITIAL SITE SKETCH

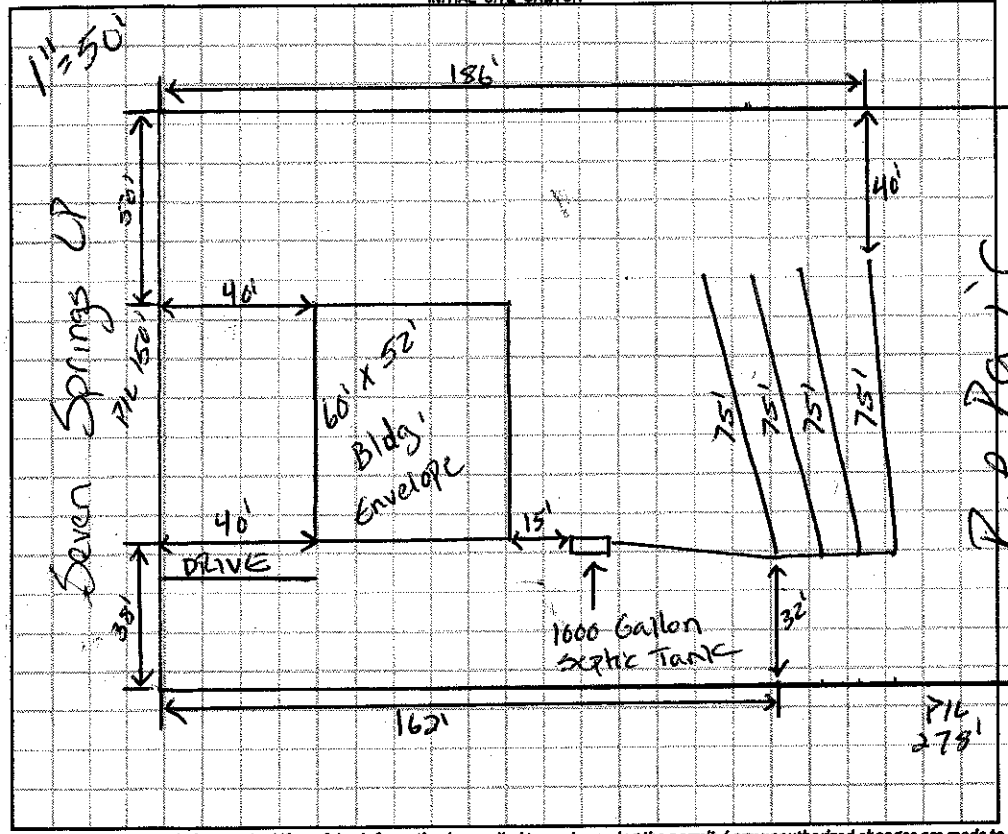


AS BUILT SKETCH

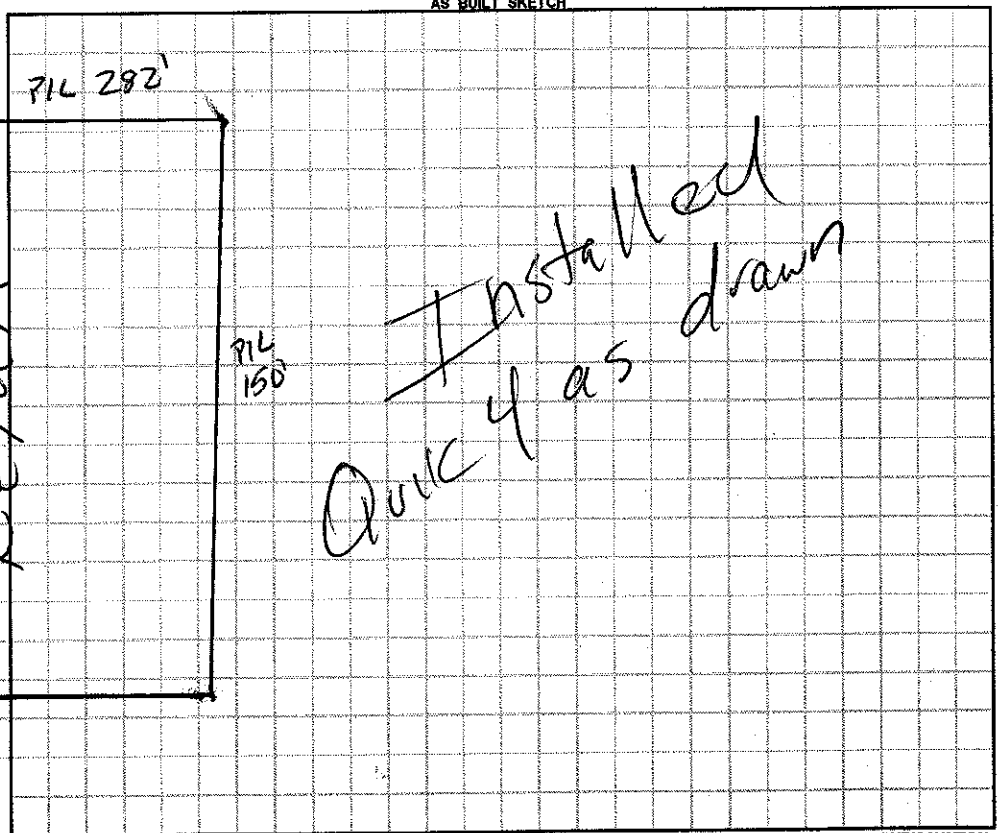


*Permit can be suspended or revoked if any false information is supplied toward securing the permit / any unauthorized changes are made to the site / any unauthorized changes are made in the installation of the system.* **CONTACT A LOCATOR SERVICE PRIOR TO ANY EXCAVATION**

☐ **IMPROVEMENT PERMIT** *with plat valid without expiration.* ☑ **IMPROVEMENT PERMIT** *with site plan valid for 60 mos.* ☑ **AUTHORIZATION TO CONSTRUCT** *valid for period equal to IMPROVEMENT PERMIT--not to exceed 60 mo.*

Owner / Applicant Signature: Theresa Martin Date: 1 Mar 16 Installed by: TB Grading

IMPROVEMENT PERMIT by: Justin Henderson Date: 3-1-16 OPERATION PERMIT by: Justin Henderson Date: 06/08/16

AUTHORIZATION TO CONSTRUCT by: Justin Henderson Date: 3-1-16 Existing System Inspected by: Date:

Health Dept. Copy - WHITE Applicant (Final Approval) - YELLOW Applicant (Conditional Approval) - PINK