IREDELL COUNTY HEALTH DEPARTMENT - *ENVIRONMENTAL HEALTH* ☐ STATESVILLE OFFICE 704-878-5305 ☐ MOORESVILLE OFFICE 704-664-5281

IMPROVEMENT PERMIT / AUTHORIZATION TO CONSTRUCT / OPERATION PERMIT / EXISTING SYSTEM INSPECTION

PERMIT # 170514 PIN # 4766-73-2196 DATE FEBRUARY 14 2012

OWNER KA WATT CONSTRUCTION APPLICANT: SAME PHONE: Home/Cell # 704-876-0047 Business # 704-902-4495

SITE ADDRESS 344 SEVEN SPRINGS LOOP OWNER / APPLICANT ADDRESS 129 BECKHAM ROAD, STATESVILLE, NC 28625

SITE DIRECTIONS OLD MOCKSVILLE ROAD TO CHESTNUT GROVE ROAD, TR 1ST SEVEN SPRINGS LOOP, 1ST LOT ON LEFT

SUBDIVISION SEVEN SPRINGS BLOCK / SECTION LOT # 71 LOT AREA 0.78 ACRE DESIGN FLOW 360 L.T.A.R. 0.30 GPD/FT2

Septic Tank 1000 Gallons: STB 1017 Date 12-2-11

Pump Tank Gallons: P T Date

Pump Make Model Serial #

No. Nitrification Fields: 1 No. Lines FOUR Linear Feet 300

Trench Width 36" Max. Trench Bottom Depth 36" Gravel Depth N/A

☑ New System ☐ Repair ☐ Expansion System Type I II III IV V VI

System Description: 25% REDUCTION, GRAVITY

Repair System Description: 25% REDUCTION, PUMP

Maintenance Agreement Required ☐ YES ☑ NO

☑ GRAVITY ☐ PRESSURE

☑ Residence No. Bedrooms 3

☐ Business No. Persons

☐ Other No. Employees


☐ Slab ☑ Crawl Space

☐ Basement w/plumbing ☐ Basement w/o plumbing


Water Supply: ☐ Private ☑ Public ☐ Community

Comments / Conditions INSTALL 25% REDUCTION SYSTEM ON CONTOUR AS SHOWN USING SERIAL DISTRIBUTION

INITIAL SITE SKETCH

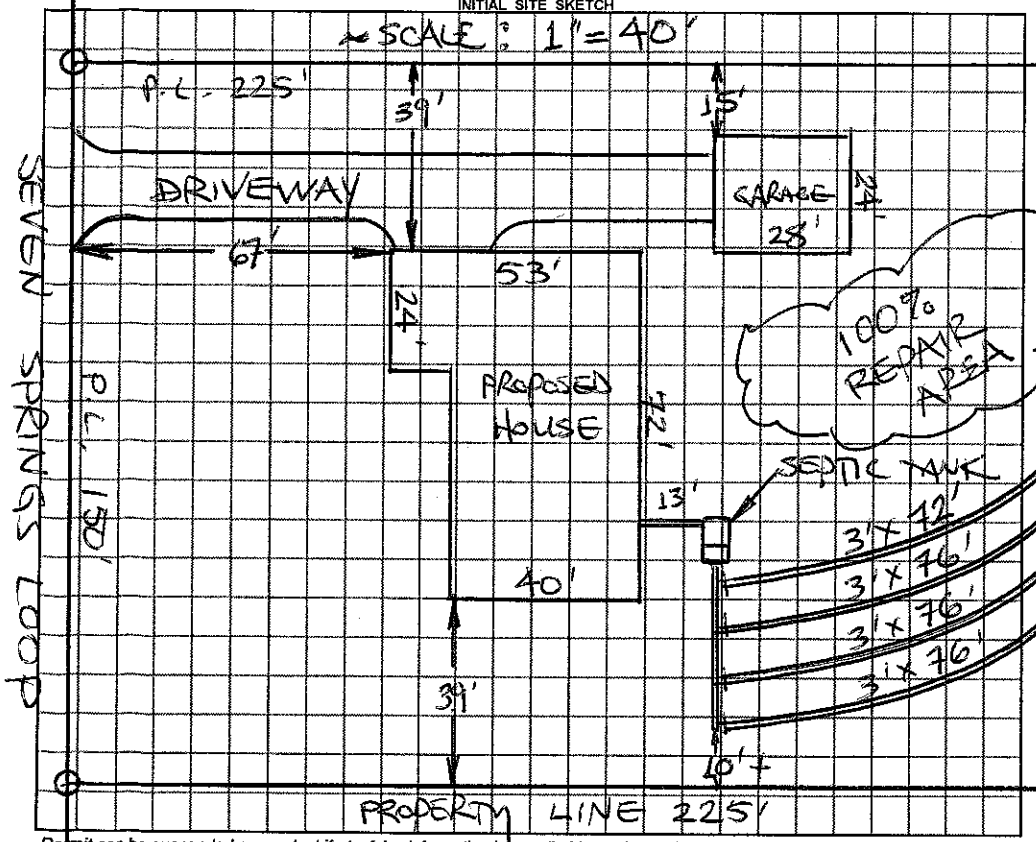

AS BUILT SKETCH

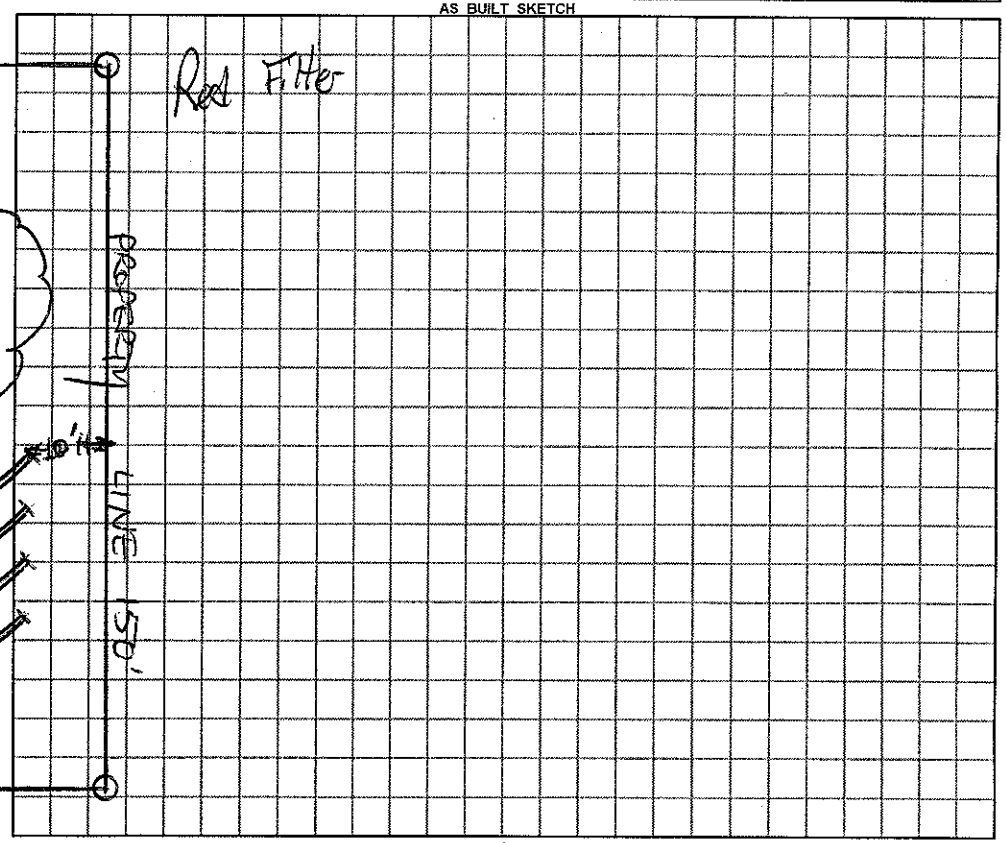

Permit can be suspended or revoked if any false information is supplied toward securing the permit / any unauthorized changes are made to the site / any unauthorized changes are made in the installation of the system.

☐ ***IMPROVEMENT PERMIT*** *with plat valid without expiration.* ☑ ***IMPROVEMENT PERMIT*** *with plat valid without expiration. site plan valid 60 mo.* ☑ ***AUTHORIZATION TO CONSTRUCT*** valid for period equal to IMPROVEMENT PERMIT--not to exceed 60 mo.

Owner / Applicant Signature: Kenneth diWatt Date 2-16-12 Installed by: Young Grading

IMPROVEMENT PERMIT by: STEVE HEDRICK REHS Date FEB 14, 2012 OPERATION PERMIT by: REHS Date 7-13-17

AUTHORIZATION TO CONSTRUCT by: STEVE HEDRICK REHS Date FEB 14, 2012 Existing System Inspected by: REHS Date

YOU SHOULD CONTACT A LOCATOR SERVICE PRIOR TO ANY EXCAVATION

White Copy – Environmental Health YELLOW COPY (Final) Owner / Applicant PINK COPY (Initial) Owner / Applicant