IREDELL COUNTY HEALTH DEPARTMENT

STATESVILLE 704-878-5305 MOORESVILLE 704-664-5281

CI

IMPROVEMENT PERMIT / AUTHORIZATION TO CONSTRUCT / OPERATION PERMIT / EXISTING SYSTEM INSPECTION

PERMIT# 100452 PIN# 4766 73 3717 DATE 5-22-01

OWNER OR CONTRACTOR KENNETH A WATT PHONE: Business 704-902-4495 Home 704-876-0047

ADDRESS 129 BECKHAM RD, STATESVILLE, NC 28625

LOCATION HWY 64 E, L RIVERHILL RD, R CHESTNUT GROVE, L ON 2nd Seven Springs Loop on left

SUBDIVISION 7SPRINGS BLOCK / SECTION LOT 67 LOT AREA .78 AC SITE CLASS PS DESIGN FLOW 360 L.T.A.R. .3

Septic Tank: 1000 Gallons; STB 1017 Date 8-6-01
Pump Tank: 1000 Gallons; PT 17 Date 8-3-01
Pump Make: GOULDS Model WE05511H Serial No. 6015302
Nitrification Field: No Fields 1 Square Feet 1200 Linear Feet 400'
No Lines 4 Trench Width 36" Max Trench Bottom Depth 36" Gravel Depth 12"

X New System ☐ Repair System Type: I. II. (III) IV. V. VI
System Description: PUMP LOW
Repair System Description: PUMP PANEL / LPPANEL
Maintenance Agreement Required: ☐ Yes X No

X House/Mod. Home ☐ Mobile Home ☐ Business ☐ Other
No. Bedrooms 3 No. Bathrooms 2 No. Employees


Water Supply: ☐ Individual X Public ☐ Community

☐ Slab X Crawl Space ☐ Basement w/plumbing ☐ Basement wo/plumbing

Comments/Conditions: (1) REPAIR PUSHED ABOVE SYSTEM TO SAVE TREE'S (2) INSTALL LINES ON CONTOUR & USE pressure manifold (3) Maintain Setbacks (4) Will FLAG OUT AFTER CLEARED (5) MAINTAIN SETBACKS

Comments/Conditions: (5) SEPTIC TANK WITH RISERS INSTALLED USING "POLYLOK" FILTER @ TANKS & DRAINFIELD INSPECTED 10.19.01 OK-RSH. EVERYTHING CHECKED 11-8-01 (6)

INITIAL SITE SKETCH 1"=50'

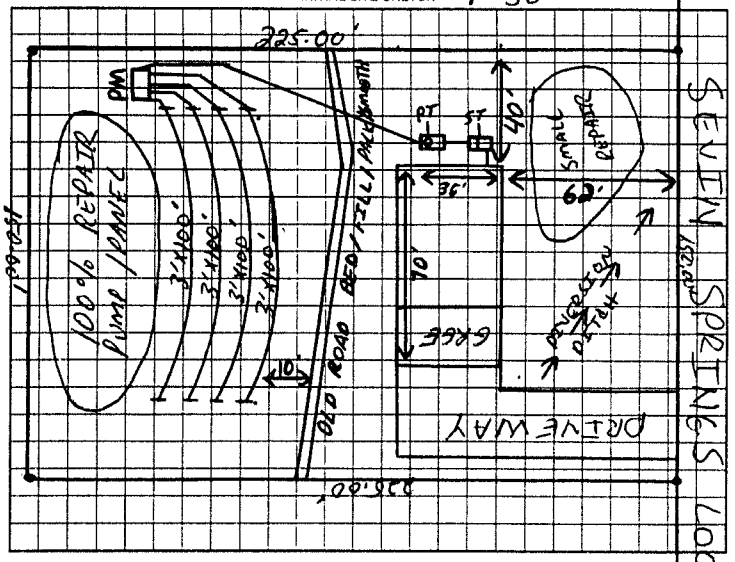

AS BUILT SKETCH

Permit can be suspended or revoked if any false information is supplied toward securing the permit/any unauthorized changes are made to the site/any unauthorized changes are made in the installation of the system. Improvement Permit with plat valid without expiration. Improvement Permit with site plan valid for sixty months. Authorization to Construct is valid for a period equal to that of Improvement Permit – not to exceed sixty months.

Signed: Kenneth A Watt date 6-25-01

Improvement Permit by: KSI date

Authorization to Construct by: date

Installed by: DAVID YOUNTZ

Operation Permit by: KS date 11-8-01

Existing System Inspection by: date

HEALTH DEPT COPY WHITE OWNER COPY (FINAL) YELLOW OWNER COPY (INITIAL) PINK