IREDELL COUNTY HEALTH DEPARTMENT

Statesville Office (704) 878-5305 Mooresville Office (704) 660-3625 PERMIT # 178444

IMPROVEMENT PERMIT / AUTHORIZATION TO CONSTRUCT / OPERATION PERMIT / EXISTING SYSTEM

PIN # 4766735349

APPLICANT: Ronald Morrison APPLICANT ADDRESS: 155 Heathrow Lane

SITE ADDRESS: 204 Seven Springs Loop PHONE: 704-902-4760 ALT. PHONE: N/A

SITE DIRECTIONS: Hwy 64 E TL old Mocksville Rd TR Chestnut Grove Rd. TR Seven Springs Loop

SUBDIVISION: Seven Springs SECTION: N/A LOT # 85 LOT AREA: .77 acres DESIGN FLOW: 360 gpd L.T.A.R.: Existing


Septic Tank	Existing	(gal)	STB	Date	☐ New System ☐ Repair ☐ Expansion System Type: I II III IV V VI	☑ Residence	No. Bedrooms	3	Water Supply
Pump Tank		(gal)	PT	Date	System Description: 25% Reduction	☐ Business	No. Persons		☐ Private
Pump Make		Model		Serial #	Repair System Description: Low Pressure 50%	☐ Other	No. Employees		☑ Public
# Nitrification Fields	Ex	# Lines	5	Linear Ft: Ex	Maintenance Agreement Required: ☐ YES ☑ NO	☐ Slab	☑ Crawl Space		☐ Community
Trench Width	Ex	Max. Trench Bottom Depth	Ex	Gravel Depth Ex	☑ GRAVITY ☐ PRESSURE	☐ Basement w/plumbing	☐ Basement w/o plumbing		

Comments / Conditions:

- Maintain a minimum of 15' between pool and all components of septic tank system + repair areas.

INITIAL SITE SKETCH

AS BUILT SKETCH

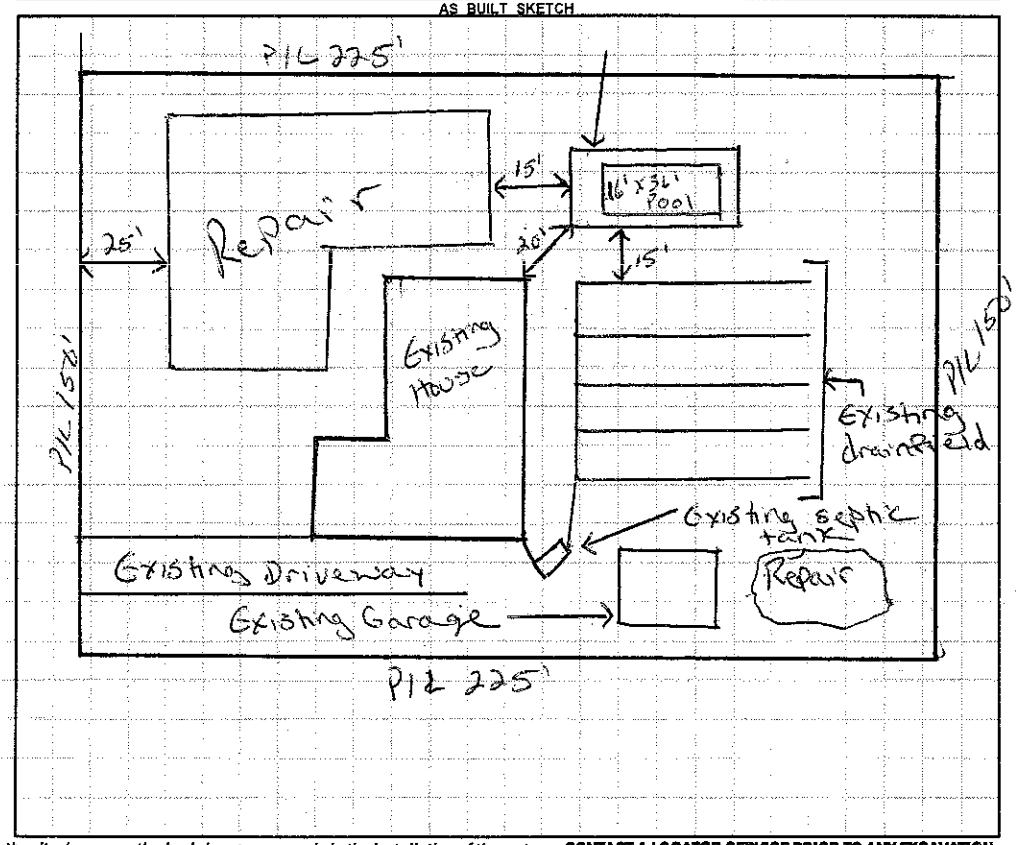

Permit can be suspended or revoked if any false information is supplied toward securing the permit / any unauthorized changes are made to the site / any unauthorized changes are made in the installation of the system. **CONTACT A LOCATOR SERVICE PRIOR TO ANY EXCAVATION**

☐ **IMPROVEMENT PERMIT** *with plat valid without expiration.* ☐ **IMPROVEMENT PERMIT** *with site plan valid for 60 mos.* ☐ **AUTHORIZATION TO CONSTRUCT** *valid for period equal to IMPROVEMENT PERMIT--not to exceed 60 mo.*

Owner / Applicant Signature: Jamie Morrison Date: 5-9-13 Installed by:

IMPROVEMENT PERMIT by: Date: OPERATION PERMIT by: Date:

AUTHORIZATION TO CONSTRUCT by: Date: Existing System Inspected by: Justin Henderson Date: 5-8-13

Health Dept. Copy - WHITE Applicant (Final Approval) - YELLOW Applicant (Conditional Approval) - PINK