IREDELL COUNTY HEALTH DEPARTMENT

STATESVILLE 704-878-5305 MOORESVILLE 704-664-5281

IMPROVEMENT PERMIT / AUTHORIZATION TO CONSTRUCT / OPERATION PERMIT / EXISTING SYSTEM INSPECTION

PERMIT# 77241 PIN# 4766 173 8146 DATE 10-30-98

OWNER OR CONTRACTOR Ft Linten Berger PHONE: Business Home 924 7064

ADDRESS 190 Twin Lakes Dr. Statesville, N.C.

LOCATION Olt Mocksville TR Chestnut Grove TR 7 Springs 1/4 mi left

SUBDIVISION 7 Springs BLOCK / SECTION LOT 19 LOT AREA .178 acres SITE CLASS 105 DESIGN FLOW 360 L.T.A.R. .32

Septic Tank: 1000 Gallons; STB 825 Date 5-11-99

Pump Tank: Gallons; PT Date

Pump Make: Model Serial No.

Nitrification Field: No Fields 1 Square Feet 1125 Linear Feet 375

No Lines 3 Trench Width 36" Max Trench Bottom Depth 36" Gravel Depth 12"

☑ New System ☐ Repair System Type: I ☑ II III IV V VI

System Description: Conv. Gravity

Repair System Description: Gravity 25% Red.

Maintenance Agreement Required: ☐ Yes ☑ No

☑ House/Mod. Home No. Bedrooms 3

☐ Mobile Home No. Bathrooms 2½

☐ Business No. Employees

☐ Other

☐ Slab ☑ Crawl Space ☐ Basement w/plumbing ☐ Basement wo/plumbing


Water Supply: ☐ Individual ☑ Public ☐ Community

Comments:/Conditions:


Comments:/Conditions:

See Attached

INITIAL SITE SKETCH

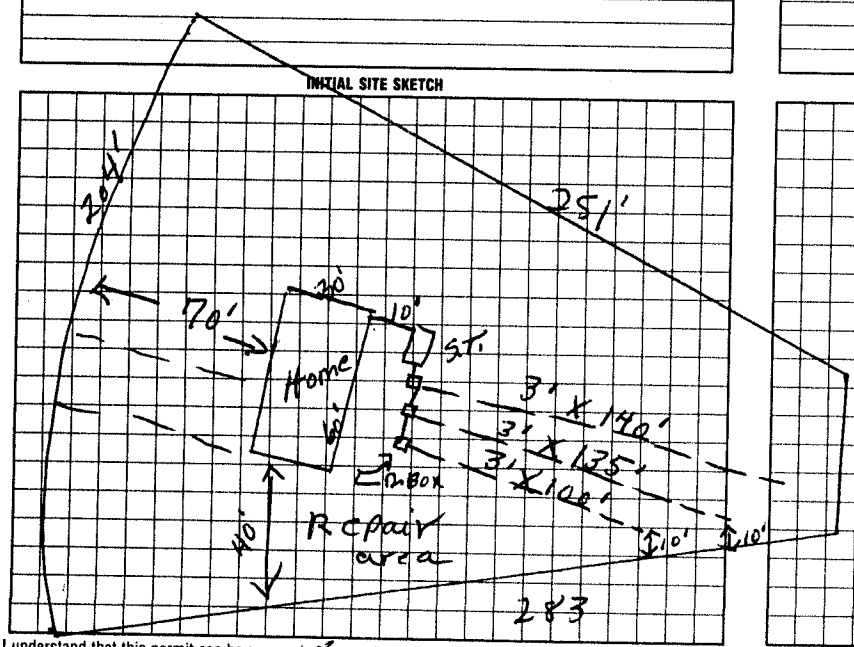

AS BUILT SKETCH

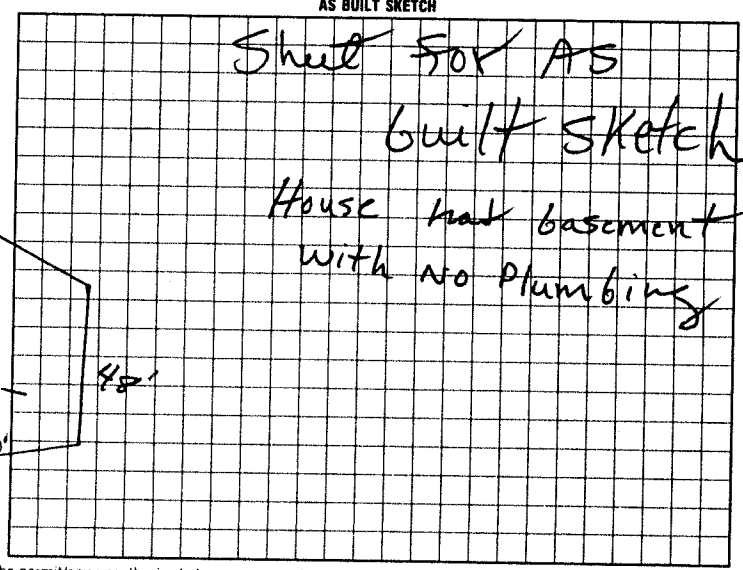

I understand that this permit can be suspended or revoked if any false information is supplied toward securing the permit/any unauthorized changes are made to the site/any unauthorized changes are made in the installation of the system. Improvement Permit with plat valid without expiration. Improvement Permit with site plan valid for sixty months. Authorization to Construct is valid for a period equal to that of Improvement Permit – not to exceed sixty months.

Signed: [signature] date 10-30-98 Installed by: Andy Daniels

Improvement Permit by: P.C. Moore date 10-30-98 Operation Permit by: P.C. Moore date 6-10-99

Authorization to Construct by: P.C. Moore date 10-30-98 Existing System Inspection by: date

HEALTH DEPT. COPY WHITE INSPECTION COPY (FINAL) GREEN OWNER COPY (FINAL) YELLOW INSPECTION COPY (INITIAL) PINK OWNER COPY (INITIAL) GOLD