IREDELL COUNTY HEALTH DEPARTMENT

STATESVILLE 704-878-5305 (C1) MOORESVILLE 704-664-5281

IMPROVEMENT PERMIT / AUTHORIZATION TO CONSTRUCT / OPERATION PERMIT / EXISTING SYSTEM INSPECTION

(C) PERMIT# 126430 PIN# 4766-73-8931 DATE 1-19-05

OWNER OR CONTRACTOR KENNETH A. WATT PHONE: Business (704) 902-4495 Home 704-876-0047

ADDRESS 129 BECKHAM RD. STATESVILLE, NC 28625

LOCATION OLD MOCKSVILLE ROAD TO CHESTNUT GROVE ROAD, TR 2ND SEVEN SPRINGS LOOP ROAD, LOT #14 on LEFT

SUBDIVISION SEVEN SPRINGS BLOCK / SECTION ____ LOT 14 LOT AREA 0.78 ACRE SITE CLASS. PS DESIGN FLOW 360 L.T.A.R. 0.30 GPD/FT2

Septic Tank: 1000 Gallons; STB ____ Date ____

Pump Tank: ____ Gallons; PT ____ Date ____

Pump Make: ____ Model ____ Serial No. ____

Nitrification Field: No Fields 1 Square Feet 1200 Linear Feet 400

No Lines FOUR Trench Width 36" Max Trench Bottom Depth 36" Gravel Depth 12"

☑ New System ☐ Repair System Type: I, II, III, IV, V, VI

System Description: CONVENTIONAL, GRAVITY

Repair System Description: 25% REDUCTION, GRAVITY

Maintenance Agreement Required: ☐ Yes ☑ No

☑ House/Mod. Home No. Bedrooms 3

☐ Mobile Home No. Bathrooms ____

☐ Business No. Employees ____

☐ Other ____


☐ Slab ☑ Crawl Space ☐ Basement w/plumbing ☐ Basement wo/plumbing

Water Supply: ☐ Individual ☑ Public ☐ Community

Comments/Conditions: INSTALL LINES ON CONTOUR

Comments/Conditions: SEPTIC TANK WITH MARKER INSTALLED USING "TUFFTITE" FILTER

INITIAL SITE SKETCH SCALE: 1" = 50'

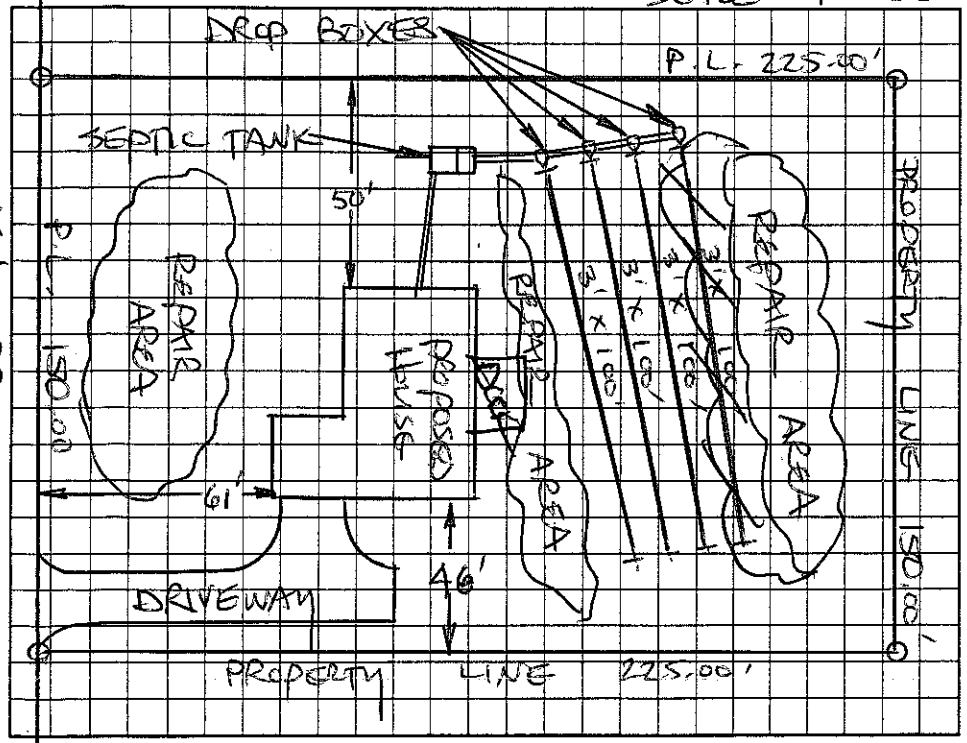

AS BUILT SKETCH

SYSTEM INSTALLED USING AN "ACCEPTED" SYSTEM OF 75 "QUICK-4" INFILTRATOR CHAMBERS

Permit can be suspended or revoked if any false information is supplied toward securing the permit/any unauthorized changes are made to the site/any unauthorized changes are made in the installation of the system. Improvement Permit with plat valid without expiration. Improvement Permit with site plan valid for sixty months. Authorization to Construct is valid for a period equal to that of Improvement Permit – not to exceed sixty months.

Signed: X [signature] date 1-19-05

Improvement Permit by: STEVE HEDRICK date 1-19-05

Authorization to Construct by: STEVE HEDRICK date 1-19-05

Installed by: DAVID YOUNTS

Operation Permit by: STEVE HEDRICK date 6-10-05

Existing System Inspection by: ____ date ____

HEALTH DEPT. COPY: WHITE OWNER COPY (FINAL): YELLOW OWNER COPY (INITIAL): PINK