(CI

IREDELL COUNTY HEALTH DEPARTMENT

STATESVILLE 704-878-5305 MOORESVILLE 704-664-5281

IMPROVEMENT PERMIT / AUTHORIZATION TO CONSTRUCT / OPERATION PERMIT / EXISTING SYSTEM INSPECTION

PERMIT# 78345 PIN# 4766740230 DATE 12-29-98

OWNER OR CONTRACTOR Todd Ellis PHONE: Business 878 6633 Home

ADDRESS 178 meadow Oaks Rd

LOCATION off Chestnut Grove Rd

SUBDIVISION 7 Springs BLOCK / SECTION LOT 43 LOT AREA .93 acres SITE CLASS P5 DESIGN FLOW 360 L.T.A.R. .3

Septic Tank: 1000 Gallons; STB 1012 Date 03-4-02
Pump Tank: Gallons; PT Date
Pump Make: Model Serial No.
Nitrification Field: No Fields 1 Square Feet 1200 Linear Feet 400
No Lines 4 Trench Width 36" Max Trench Bottom Depth 36" Gravel Depth 12"

[x] New System [ ] Repair System Type: [ ] I [x] II [ ] III, IV, V, VI
System Description: Conv. Gravity
Repair System Description: Gravity 25% Red
Maintenance Agreement Required: [ ] Yes [ ] No


[x] House/Mod. Home No. Bedrooms 3
[ ] Mobile Home No. Bathrooms 2
[ ] Business No. Employees
Other
[ ] Slab [ ] Crawl Space [x] Basement w/plumbing [ ] Basement wo/plumbing

Water Supply: [ ] Individual [x] Public [ ] Community


Comments/Conditions:

Comments/Conditions: POLYLOK FILTER & MARKER - 7 RISERS

INITIAL SITE SKETCH

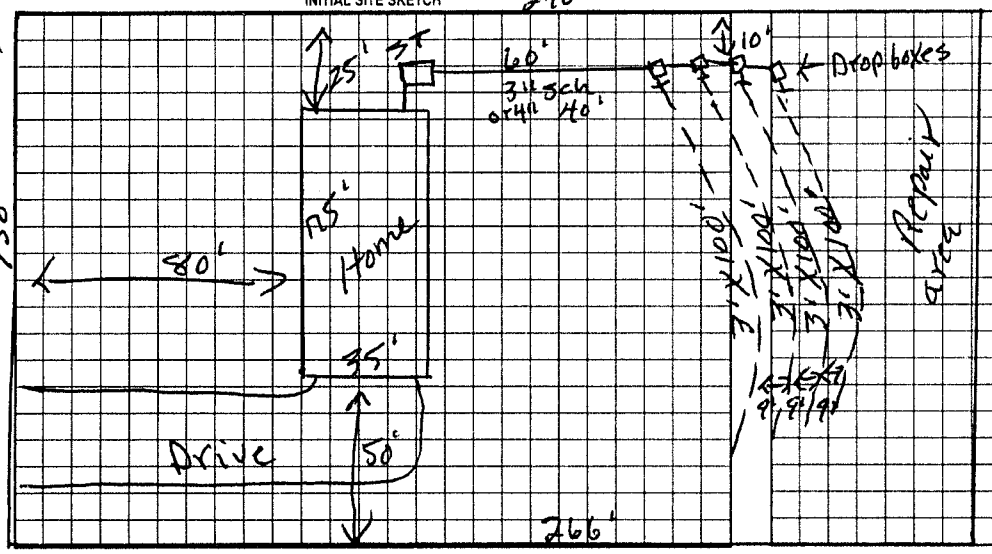

AS BUILT SKETCH

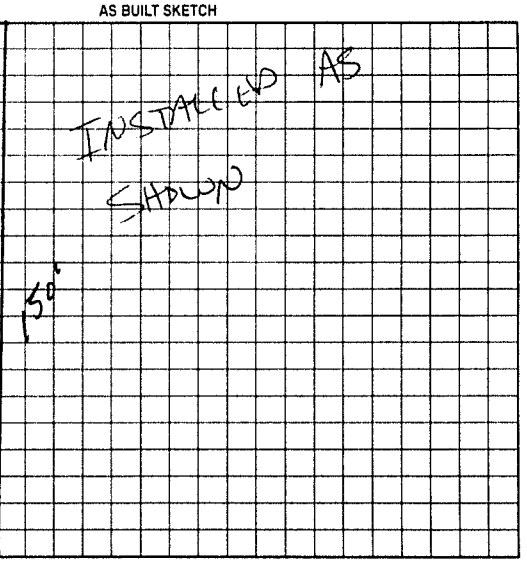

Permit can be suspended or revoked if any false information is supplied toward securing the permit/any unauthorized changes are made to the site/any unauthorized changes are made in the installation of the system. Improvement Permit with plat valid without expiration. Improvement Permit with site plan valid for sixty months. Authorization to Construct is valid for a period equal to that of Improvement Permit – not to exceed sixty months.

Signed: Todd Ellis date 1-7-99 Installed by: DAVID YOUNTZ

Improvement Permit by: P.C. Moore date 12-29-98 Operation Permit by: date 05-13-02

Authorization to Construct by: P.C. Moore date 12-29-98 Existing System Inspection by: date

HEALTH DEPT COPY: WHITE OWNER COPY (FINAL): YELLOW OWNER COPY (INITIAL): PINK