IREDELL COUNTY HEALTH DEPARTMENT

STATESVILLE 704-878-5305 MOORESVILLE 704-664-5281

IMPROVEMENT PERMIT / AUTHORIZATION TO CONSTRUCT / OPERATION PERMIT / EXISTING SYSTEM INSPECTION

PERMIT# 86401 PIN# 4766740551 DATE 11-23-99

OWNER OR CONTRACTOR Staten Fox PHONE: Business Home 878 6633

ADDRESS 2199 Chipley Ford Rd Statesville, N.C.

LOCATION Old Mocksville Rd TR Chestnut Grove TR 1st R Sp loop 1500 Rt

SUBDIVISION Seven Sp. BLOCK / SECTION LOT 45 LOT AREA .9 acres SITE CLASS PS DESIGN FLOW 360 L.T.A.R. .33 gal/ss/day

Septic Tank: 1000 Gallons; STB 1012 Date 5-8-00
Pump Tank: Gallons; PT Date
Pump Make: Model Serial No.
Nitrification Field; No Fields 1 Square Feet 1080 Linear Feet 360
No Lines 4 Trench Width 36" Max Trench Bottom Depth 36" Gravel Depth 12"

☑ New System ☐ Repair System Type: I ☐ II. III. IV. V. VI
System Description: Conv. Gravity
Repair System Description:
Maintenance Agreement Required: ☐ Yes ☑ No
☐ Slab ☐ Crawl Space ☑ Basement w/plumbing ☐ Basement wo/plumbing


☑ House/Mod. Home No. Bedrooms 3
☐ Mobile Home No. Bathrooms 3
☐ Business No. Employees
☐ Other

Water Supply: ☐ Individual ☑ Public ☐ Community


Comments/Conditions:

Comments/Conditions SEPTIC TANK W/ RISERS INSTALLED USING "POLYLOK" FILTER

INITIAL SITE SKETCH

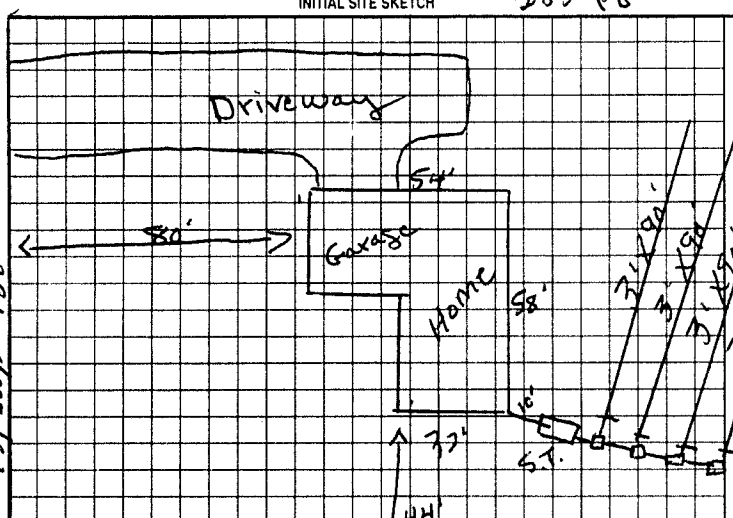

AS BUILT SKETCH

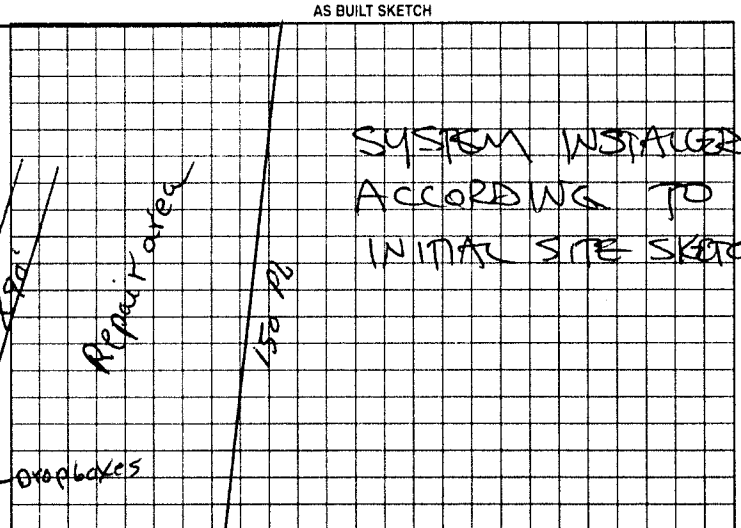

Permit can be suspended or revoked if any false information is supplied toward securing the permit/any unauthorized changes are made to the site/any unauthorized changes are made in the installation of the system. Improvement Permit with plat valid without expiration. Improvement Permit with site plan valid for sixty months. Authorization to Construct is valid for a period equal to that of Improvement Permit – not to exceed sixty months.

Signed: X. E. Wayne Rose Bentley date Installed by: DAVID YOUNTZ

Improvement Permit by: P. C. Moore date 11-23-99 Operation Permit by: STEVE HEDRICK date 8-10-00

Authorization to Construct by: P. C. Moore date 11-23-99 Existing System Inspection by: date

HEALTH DEPT. COPY: WHITE OWNER COPY (FINAL): YELLOW OWNER COPY (INITIAL): PINK