IREDELL COUNTY HEALTH DEPARTMENT

STATESVILLE 704-878-5305 MOORESVILLE 704-664-5281

IMPROVEMENT PERMIT / AUTHORIZATION TO CONSTRUCT / OPERATION PERMIT / EXISTING SYSTEM INSPECTION

PERMIT# 81699 PIN# 4766743542 DATE 6-14-99

OWNER OR CONTRACTOR Todd Rhyne PHONE: Business 876 2124 Home

ADDRESS 816 Whites Farm Rd Statesville

LOCATION 64 E TL Riverhill TL Chestnut Grove TL 2nd Entrance

SUBDIVISION Seven Sp BLOCK / SECTION LOT 62 LOT AREA .78 acres SITE CLASS DS DESIGN FLOW 360 L.T.A.R. .33

Septic Tank: 1000 Gallons; STB Date

Pump Tank: Gallons; PT Date

Pump Make: Model Serial No.

Nitrification Field: No Fields 1 Square Feet 1080 Linear Feet 360

No Lines 4 Trench Width 36" Max Trench Bottom Depth 36" Gravel Depth 12"

☑ New System ☐ Repair System Type: I (II) III, IV, V, VI

System Description: Conv. Gravity

Repair System Description:

Maintenance Agreement Required: ☐ Yes ☑ No

☑ House/Mod. Home No. Bedrooms 3

☐ Mobile Home No. Bathrooms 2

☐ Business No. Employees

☐ Other


☐ Slab ☑ Crawl Space ☐ Basement w/plumbing ☐ Basement wo/plumbing

Water Supply: ☐ Individual ☑ Public ☐ Community

Comments/Conditions

Comments/Conditions

INITIAL SITE SKETCH 225'

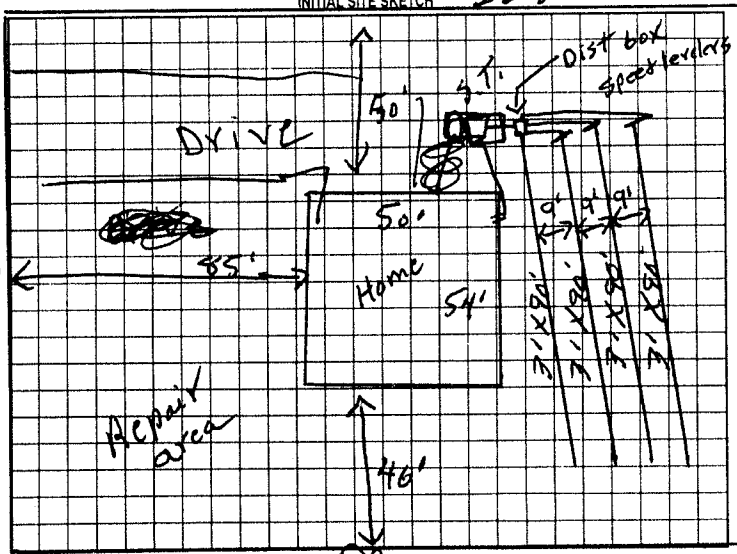

AS BUILT SKETCH

Same as initial Sketch position Except D/S S.T. Due To Drive way change

Permit can be suspended or revoked if any false information is supplied toward securing the permit/any unauthorized changes are made to the site/any unauthorized changes are made in the installation of the system. Improvement Permit with plat valid without expiration. Improvement Permit with site plan valid for sixty months. Authorization to Construct is valid for a period equal to that of Improvement Permit – not to exceed sixty months.

Signed: Todd A. Rhyne date Installed by: Tommy Frye

Improvement Permit by: P. C. Moore date 6-14-99 Operation Permit by: P.C. Moore date 11-12-99

Authorization to Construct by: P. C. Moore date 6-14-99 Existing System Inspection by: date

HEALTH DEPT COPY WHITE OWNER COPY (FINAL) YELLOW OWNER COPY (INITIAL) PINK