pd. 125 CK

IREDELL COUNTY HEALTH DEPARTMENT

STATESVILLE 704-878-5305 MOORESVILLE 704-664-5281

IMPROVEMENT PERMIT / AUTHORIZATION TO CONSTRUCT / OPERATION PERMIT / EXISTING SYSTEM INSPECTION

PERMIT# 094547 PIN# 4766743842 13957

OWNER OR CONTRACTOR BARRY WILLIAMS PHONE. Business 528-9806 DATE 02/26/01

ADDRESS 2504 DUNMORE CT Home 919-554-9665

LOCATION 64E, RIVER HILL, CHESTNUT GROVE, 2nd Left into SEVEN SPRINGS

SUBDIVISION SEVEN SPRINGS BLOCK / SECTION ____ LOT 60 LOT AREA 1.54 SITE CLASS PS DESIGN FLOW 480 L.T.A.R. .3

Septic Tank: 1000 Gallons: STB 1007 Date 9/6/01

Pump Tank: ____ Gallons: PT ____ Date ____

Pump Make: ____ Model ____ Serial No. ____

Nitrification Field: No Fields 1 Square Feet ED to 1600' Linear Feet 400'

No Lines 3 Trench Width 36" Max Trench Bottom Depth 30"

X New System ☐ Repair System Type: I, II, III, IV, V, VI

System Description: 25% REDUCTION/LEAK

Repair System Description: 25% REDUCTION/LEAK

Maintenance Agreement Required: ☐ Yes X No

Gravel Depth N/A

X House/Mod. Home No. Bedrooms 4

☐ Mobile Home No. Bathrooms 3

☐ Business No. Employees ____

☐ Other ____

☐ Slab X Crawl Space ☐ Basement w/plumbing ☐ Basement wo/plumbing


Water Supply: ☐ Individual X Public ☐ Community

Comments/Conditions: ① INSTALL LINES ON CONTOUR ② STAY 15' off WASHOUT, 10' off property lines, 45' off house. ③ Use 25% REDUCT. SYSTEM

Comments/Conditions

- Poly 10 K Filter installed
- Septic Tank Marker installed
- Infiltrator Chamber Installed (67)

INITIAL SITE SKETCH

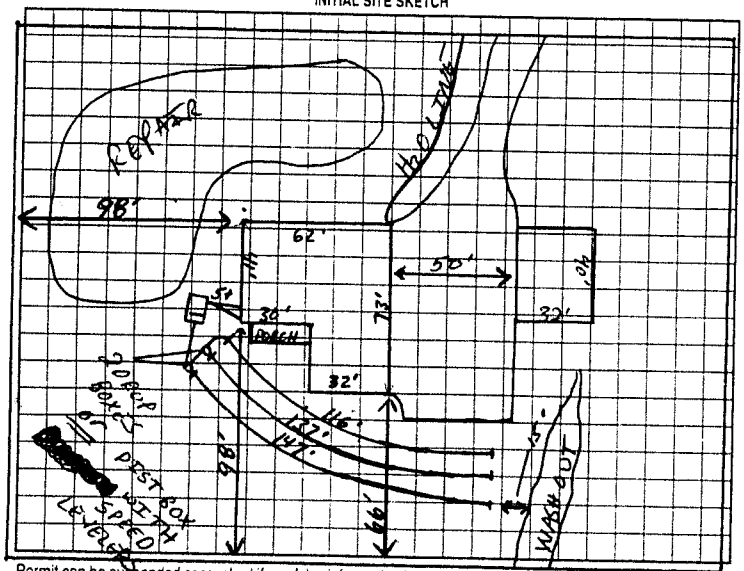

AS BUILT SKETCH

Installed ditt box w/ Spread laterals

Installed as Shown per Initial Site Sketch

Permit can be suspended or revoked if any false information is supplied toward securing the permit/any unauthorized changes are made to the site/any unauthorized changes are made in the installation of the system. Improvement Permit with plat valid without expiration. Improvement Permit with site plan valid for sixty months. Authorization to Construct is valid for a period equal to that of Improvement Permit – not to exceed sixty months.

Signed: Barry C. Williams date 2/15/01 Installed by: James Hadler

Improvement Permit by: Jim Cook REHS date 02-26-01 Operation Permit by: William O. Johnson date 10/10/01

Authorization to Construct by: Jim Cook REHS date 02-26-01 Existing System Inspection by: ____ date ____

HEALTH DEPT COPY: WHITE OWNER COPY (FINAL): YELLOW OWNER COPY (INITIAL): PINK