IREDELL COUNTY HEALTH DEPARTMENT

STATESVILLE 704-878-5305 MOORESVILLE 704-664-5281

IMPROVEMENT PERMIT / AUTHORIZATION TO CONSTRUCT / OPERATION PERMIT / EXISTING SYSTEM INSPECTION

PERMIT# 88953 PIN# 4766745680 DATE 5/9/00

OWNER OR CONTRACTOR TODD S ELLIS PHONE: Business 878-6633 Home

ADDRESS 315 SEVEN SPRINGS LOOP STATESVILLE NC 28625

LOCATION 21 N - TR JANE SOWERS - TL OLD MOCKSVILLE - TR CHESTNUT GRVG - TR SEVEN SPRINGS 2nd Entrance - ON RT

SUBDIVISION SEVEN SPRINGS BLOCK / SECTION LOT 93 LOT AREA .78 AC SITE CLASS PS DESIGN FLOW 360GPD L.T.A.R. 3 gal/ft²

Septic Tank: 1000 Gallons: STB 1012 Date 8-20-00
Pump Tank: Gallons: PT Date
Pump Make: Model Serial No.
Nitrification Field: No Fields 1 Square Feet 1200 Linear Feet 400
No Lines 4@100' Trench Width 36" Max Trench Bottom Depth 36" Gravel Depth 12"

☒ New System ☐ Repair System Type: I (II) III IV V VI
System Description: GRAVITY CONVENTIONAL
Repair System Description: SAME
Maintenance Agreement Required: ☐ Yes ☒ No

☒ House/Mod. Home No. Bedrooms 3
☐ Mobile Home No. Bathrooms 2
☐ Business No. Employees
☐ Other


☐ Slab ☒ Crawl Space ☐ Basement w/plumbing ☐ Basement wo/plumbing

Water Supply: ☐ Individual ☒ Public ☐ Community

Comments/Conditions:

Comments/Conditions: SEPTIC TANK W/ RISERS INSTALLED USING "POLY LOK" FILTER

INITIAL SITE SKETCH 1"=50'

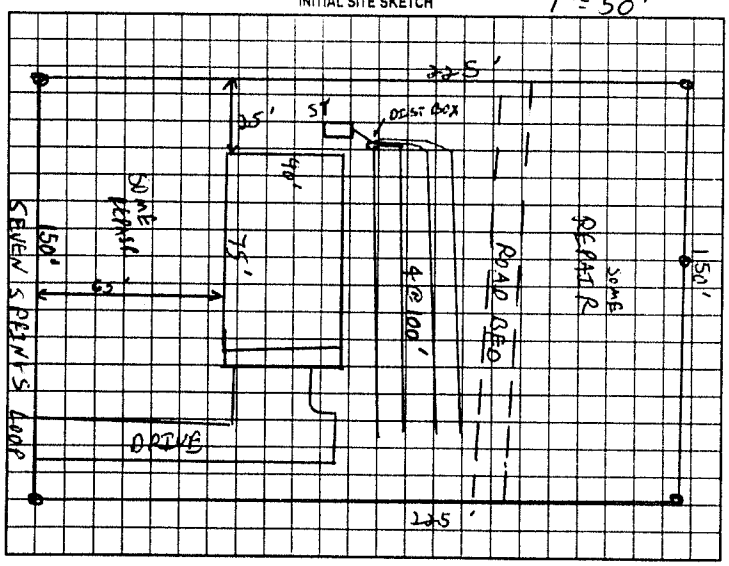

AS BUILT SKETCH

SYSTEM INSTALLED ACCORDING TO INITIAL SITE SKETCH

Permit can be suspended or revoked if any false information is supplied toward securing the permit/any unauthorized changes are made to the site/any unauthorized changes are made in the installation of the system. Improvement Permit with plat valid without expiration. Improvement Permit with site plan valid for sixty months. Authorization to Construct is valid for a period equal to that of Improvement Permit – not to exceed sixty months.

Signed: [signature] date 5/9/00

Improvement Permit by: C. Ray Freeman RS date 5/9/00

Authorization to Construct by: C. Ray Freeman RS date 5/9/00

Installed by: DAVID YOUNTZ

Operation Permit by: STEVE HEDRICK date 9-25-00

Existing System Inspection by: date

HEALTH DEPT. COPY. WHITE OWNER COPY (FINAL) YELLOW OWNER COPY (INITIAL) PINK