IREDELL COUNTY HEALTH DEPARTMENT

STATESVILLE 704-878-5305 MOORESVILLE 704-664-5281

IMPROVEMENT PERMIT / AUTHORIZATION TO CONSTRUCT / OPERATION PERMIT / EXISTING SYSTEM INSPECTION

PERMIT# 83483 PIN# 4766745990 DATE 8-25-99

OWNER OR CONTRACTOR Lisa Buhrmaster PHONE: Business Home 704 556 0300

ADDRESS [redacted] 13624 Quixley LN Charlotte N.C.

LOCATION US 64 E TO River Hill RD TO Chestnut Grove RD TO Sploop 1000' RT

SUBDIVISION 7 Springs BLOCK / SECTION LOT 95 LOT AREA 1.78 acres SITE CLASS PS DESIGN FLOW 360 L.T.A.R. .13

Septic Tank: 1000 Gallons: STB 1012 Date 11-21-99
Pump Tank: Gallons: PT Date
Pump Make: Model Serial No.
Nitrification Field: No Fields 1 Square Feet 1200 Linear Feet 400
No Lines 4 Trench Width 36" Max Trench Bottom Depth 36" Gravel Depth 12"

☑ New System ☐ Repair System Type: ☐ I ☐ II ☐ III ☐ IV ☐ V ☐ VI
System Description: Conv. Gravity
Repair System Description: Gravity 2590 Rdtn.
Maintenance Agreement Required: ☐ Yes ☑ No


☑ House/Mod. Home No. Bedrooms 3
☐ Mobile Home No. Bathrooms 2
☐ Business No. Employees
☐ Other
☐ Slab ☑ Crawl Space ☐ Basement w/plumbing ☐ Basement wo/plumbing

Water Supply: ☐ Individual ☑ Public ☐ Community


Comments/Conditions:

Comments/Conditions: 3 Flow Dividers

INITIAL SITE SKETCH

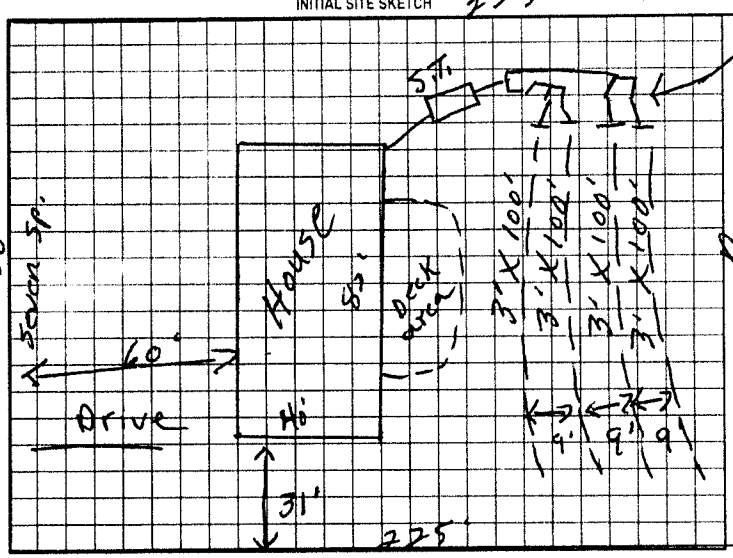

AS BUILT SKETCH

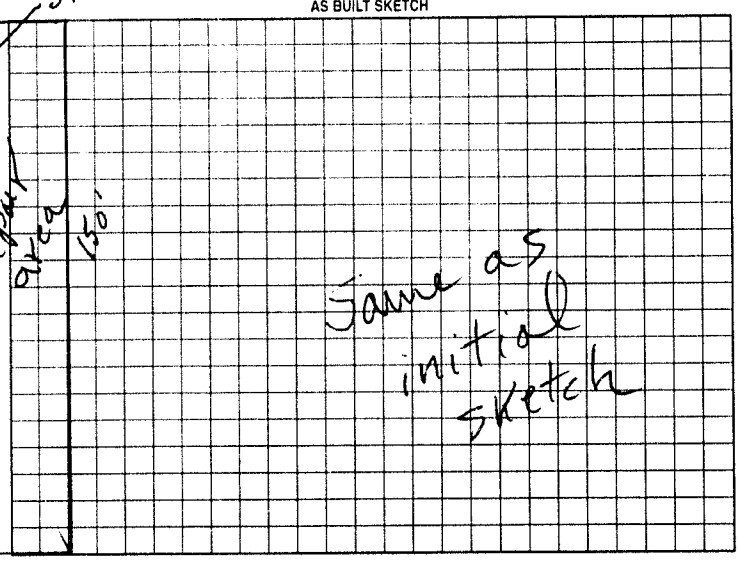

Permit can be suspended or revoked if any false information is supplied toward securing the permit/any unauthorized changes are made to the site/any unauthorized changes are made in the installation of the system. Improvement Permit with plat valid without expiration. Improvement Permit with site plan valid for sixty months. Authorization to Construct is valid for a period equal to that of Improvement Permit – not to exceed sixty months.

Signed: Lisa Buhrmaster date 8-25-99 Installed by: Kenny Matison

Improvement Permit by: P.C. Moore date 8-25-99 Operation Permit by: P.C. Moore date 3-28-00

Authorization to Construct by: P.C. Moore date 8-25-99 Existing System Inspection by: date

HEALTH DEPT COPY WHITE OWNER COPY (FINAL) YELLOW OWNER COPY (INITIAL) PINK