IREDELL COUNTY HEALTH DEPARTMENT - *ENVIRONMENTAL HEALTH* ☒ STATESVILLE OFFICE 704-878-5305 ☐ MOORESVILLE OFFICE 704-664-5281

IMPROVEMENT PERMIT / AUTHORIZATION TO CONSTRUCT / OPERATION PERMIT / EXISTING SYSTEM INSPECTION

PERMIT # 165738 PIN # 4766-75-1500 DATE 3-23-11

OWNER Barry L. Koontz APPLICANT: KA Watt Const. Inc. PHONE: Home/Cell # 704 902 4495 Business #

SITE ADDRESS 1745 Seven Springs Loop OWNER / APPLICANT ADDRESS 129 Beckham Rd

SITE DIRECTIONS Old Mocksville Rd (R) Chestnut Grove Rd (R) on Seven Spring Loop, 3rd lot on Right

SUBDIVISION Seven Springs BLOCK / SECTION LOT # 51 LOT AREA .813 DESIGN FLOW 360 L.T.A.R. .5

Septic Tank Ex Gallons: STB Ex Date Ex

Pump Tank Gallons: P T Date

Pump Make Model Serial #

No. Nitrification Fields: 1 No. Lines 3 Linear Feet 240

Trench Width Ex Max. Trench Bottom Depth Ex Gravel Depth Ex.

☒ New System ☐ Repair ☐ Expansion System Type I (II) III IV V VI

System Description: Gravity Conventional

Repair System Description: Pump 25% Reduction

Maintenance Agreement Required ☐ YES ☒ NO

☒ GRAVITY ☐ PRESSURE

☒ Residence No. Bedrooms 3

☐ Business No. Persons

☐ Other No. Employees

☐ Slab ☒ Crawl Space

☐ Basement w/plumbing ☐ Basement w/o plumbing

Water Supply

☐ Private

☒ Public


☐ Community

Comments / Conditions

Keep traffic off tanks and system

INITIAL SITE SKETCH

AS BUILT SKETCH

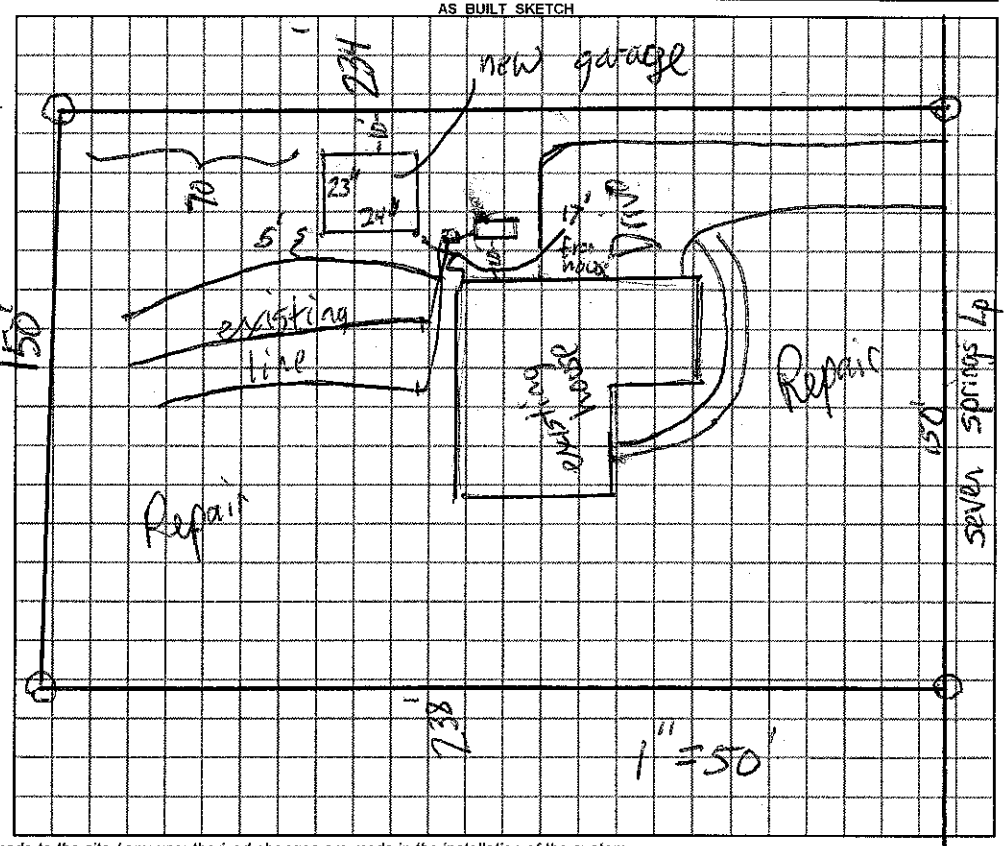

Permit can be suspended or revoked if any false information is supplied toward securing the permit / any unauthorized changes are made to the site / any unauthorized changes are made in the installation of the system.

☐ ***IMPROVEMENT PERMIT*** *with plat valid without expiration.* ☐ ***IMPROVEMENT PERMIT*** *with ~~plat valid without expiration.~~ site plan valid 60 mo.* ☐ ***AUTHORIZATION TO CONSTRUCT*** valid for period equal to IMPROVEMENT PERMIT--not to exceed 60 mo.

Owner / Applicant Signature: Date 3-23-11 Installed by:

IMPROVEMENT PERMIT by: REHS Date

AUTHORIZATION TO CONSTRUCT by: REHS Date

OPERATION PERMIT by: REHS Date

Existing System Inspected by: REHS Date 3-23-11

YOU SHOULD CONTACT A LOCATOR SERVICE PRIOR TO ANY EXCAVATION

White Copy – Environmental Health YELLOW COPY (Final) Owner / Applicant PINK COPY (Initial) Owner / Applicant