IREDELL COUNTY HEALTH DEPARTMENT - *ENVIRONMENTAL HEALTH* ☑ STATESVILLE OFFICE 704-878-5305 ☐ MOORESVILLE OFFICE 704-664-5281

IMPROVEMENT PERMIT / AUTHORIZATION TO CONSTRUCT / OPERATION PERMIT / EXISTING SYSTEM INSPECTION

PERMIT # 165031 PIN # 4766-75-1823 DATE 17 February 2011

OWNER Michael + Judy Campbell APPLICANT: K.W. Watt Const. PHONE: Home/Cell # (704) 902-4495 Business #

SITE ADDRESS 459 Seven Springs Loop Statesville OWNER / APPLICANT ADDRESS

SITE DIRECTIONS Jane Sowers Rd. TL old Mocksville Rd. TR Chestnut Grove Rd. Seven Springs Lp. W - on Rt.

SUBDIVISION Seven Springs BLOCK / SECTION P1 LOT # 53 LOT AREA 1.2 ac DESIGN FLOW 360 gpd L.T.A.R. 0.3 / 432

Septic Tank 1000 Gallons: STB 1012 Date 3-24-15
Pump Tank n/a Gallons: P T n/a Date n/a
Pump Make n/a Model Delta Rite Serial # EF4
No. Nitrification Fields: 1 No. Lines 4 Linear Feet 300
Trench Width 36" Max. Trench Bottom Depth 36" Gravel Depth n/a


☑ New System ☐ Repair ☐ Expansion System Type I II (III) IV V VI
System Description: 25% Reduction System
Repair System Description: 25% Reduction System
Maintenance Agreement Required ☐ YES ☑ NO
☑ GRAVITY ☐ PRESSURE

☑ Residence No. Bedrooms 3
☐ Business No. Persons
☐ Other No. Employees
☐ Slab ☑ Crawl Space
☐ Basement w/plumbing ☐ Basement w/o plumbing


Water Supply: ☐ Private ☑ Public ☐ Community

Comments / Conditions
Chestnut Grove Rd.

INITIAL SITE SKETCH

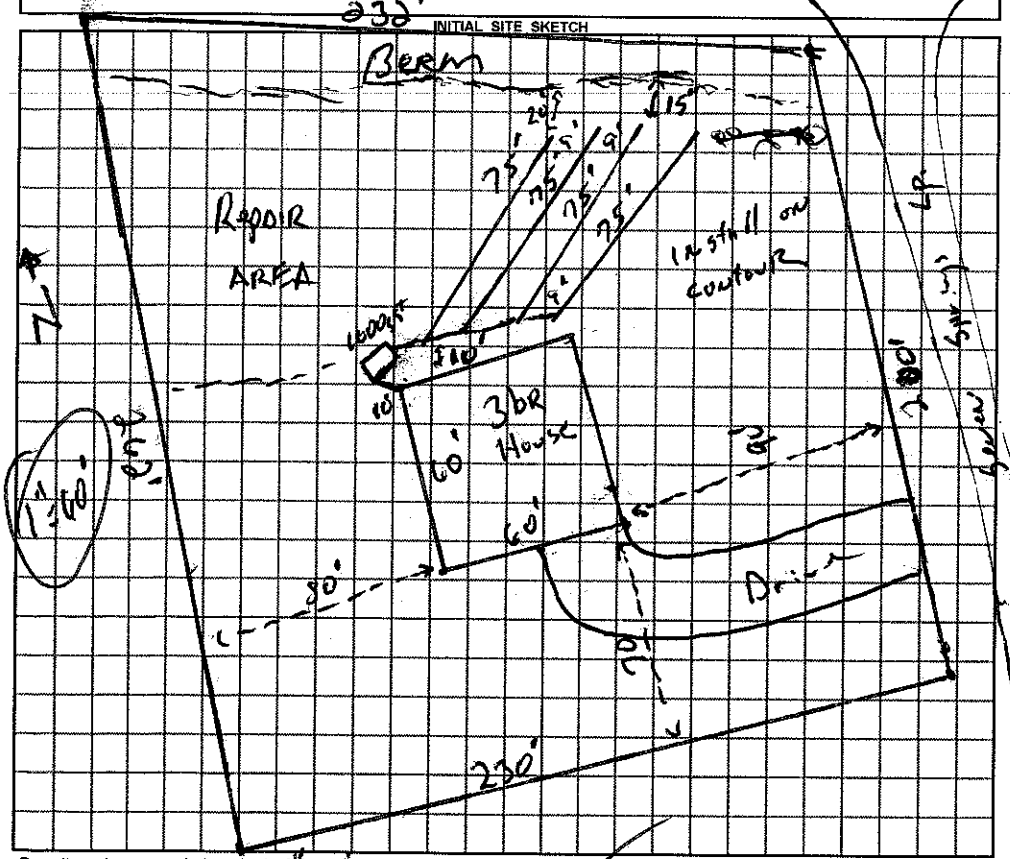

AS BUILT SKETCH

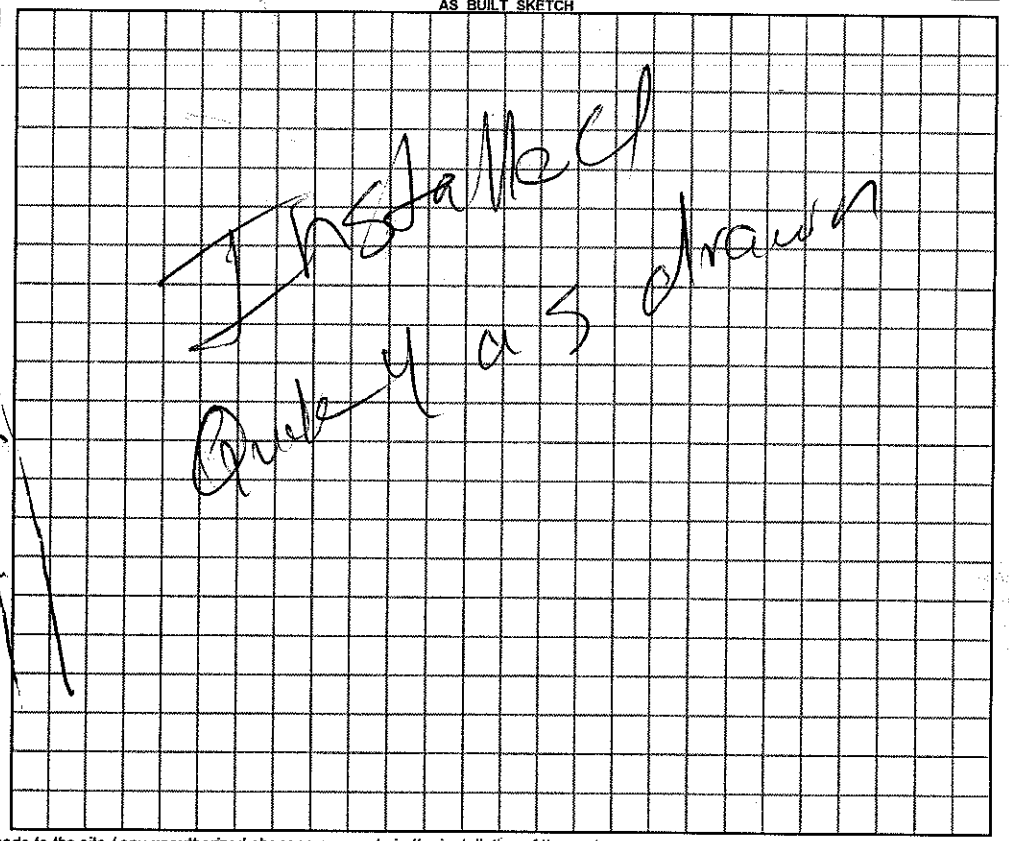

Permit can be suspended or revoked if any false information is supplied toward securing the permit / any unauthorized changes are made to the site / any unauthorized changes are made in the installation of the system.

☐ *IMPROVEMENT PERMIT* with plat valid without expiration ☑ *IMPROVEMENT PERMIT* with plat valid without expiration 60 mo ☐ *AUTHORIZATION TO CONSTRUCT* valid for period equal to IMPROVEMENT PERMIT--not to exceed 60 mo.

Owner / Applicant Signature: [signature] Date 2-25-11

IMPROVEMENT PERMIT by: [signature] REHS Date 17 Feb 11

AUTHORIZATION TO CONSTRUCT by: [signature] REHS Date 10-2-15

YOU SHOULD CONTACT A LOCATOR SERVICE PRIOR TO ANY EXCAVATION

Installed by: Yount Septic

OPERATION PERMIT by: [signature] REHS Date 02/10/16

Existing System Inspected by: REHS Date

White Copy -- Environmental Health YELLOW COPY (Final) Owner / Applicant PINK COPY (Initial) Owner / Applicant