IREDELL COUNTY HEALTH DEPARTMENT

STATESVILLE 704-878-5305 MOORESVILLE 704-664-5281

IMPROVEMENT PERMIT / AUTHORIZATION TO CONSTRUCT / OPERATION PERMIT / EXISTING SYSTEM INSPECTION

PERMIT# 128515 PIN# 4766-75-3471 DATE 6-1-05

OWNER OR CONTRACTOR KENNETH A. WATT PHONE: Business 704-902-4495 Home 704-876-0097

ADDRESS 129 BECKHAM ROAD, STATESVILLE, NC 28625

LOCATION OLD MOCKSVILLE ROAD NE, TR CHESTNUT GROVE RD, TR LT SEVEN SPRINGS LOOP, 3RD LOT ON LEFT

SUBDIVISION SEVEN SPRINGS BLOCK / SECTION 1 LOT 56 LOT AREA 0.775 ACRE SITE CLASS. PS DESIGN FLOW 360' L.T.A.R. 0.30 GPD/FT2

Septic Tank: 1000 Gallons; STB 10K Date 5-7-07
Pump Tank: ____ Gallons; PT ____ Date ____
Pump Make: ____ Model ____ Serial No. ____
Nitrification Field: No Fields 1 Square Feet 1200 Linear Feet 400
No Lines FIVE Trench Width 36" Max Trench Bottom Depth 36" Gravel Depth 12"

☑ New System ☐ Repair System Type: I, II, III, IV, V, VI
System Description: CONVENTIONAL, GRAVITY
Repair System Description: 25% REDUCTION, PUMP
Maintenance Agreement Required: ☐ Yes ☑ No


☑ House/Mod. Home No. Bedrooms 3
☐ Mobile Home No. Bathrooms ____
☐ Business No. Employees ____
☐ Other ____
☐ Slab ☑ Crawl Space ☐ Basement w/plumbing ☐ Basement wo/plumbing

Water Supply: ☐ Individual ☑ Public ☐ Community

Comments:/Conditions: AN "ACCEPTED" SYSTEM MAY BE INSTALLED. INSTALL LINES ON CONTOUR.


Comments:/Conditions: 25% Reduction 300' of line 3@ 100'

SCALE: 1" = 40' INITIAL SITE SKETCH

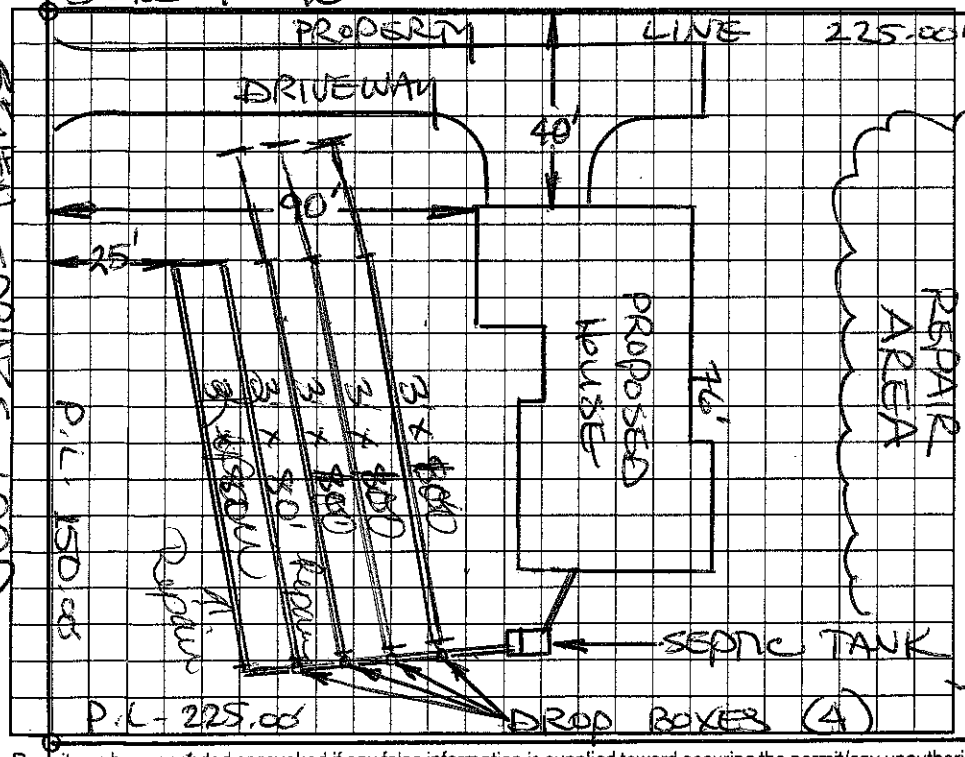

AS BUILT SKETCH

Yellow Lid tank
Septic Tank Marker

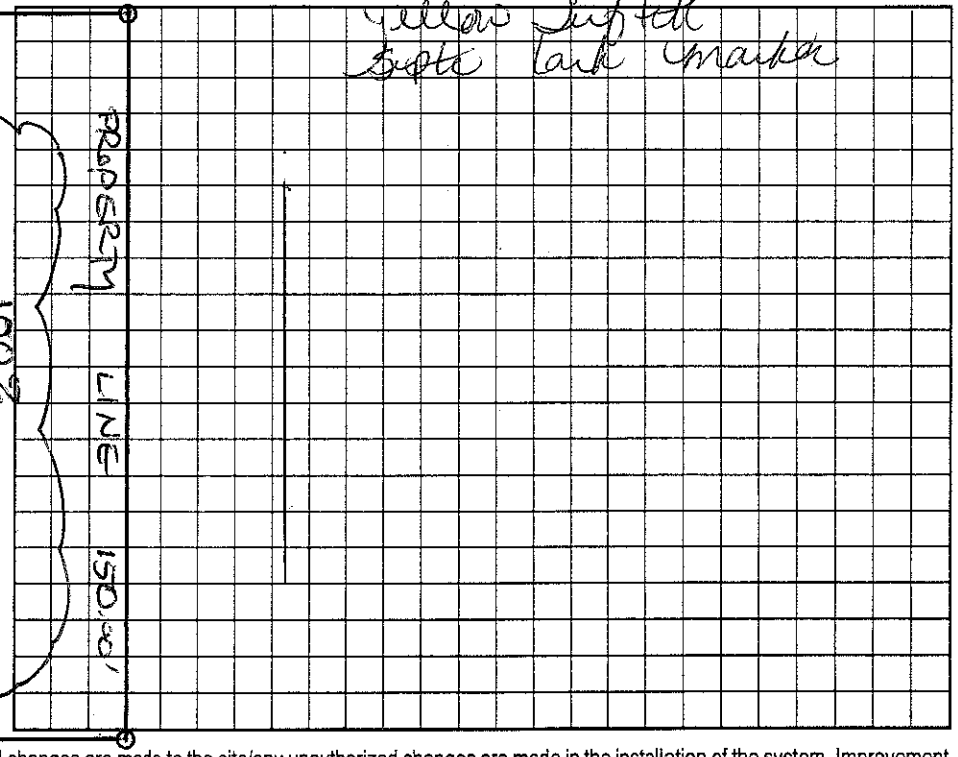

Permit can be suspended or revoked if any false information is supplied toward securing the permit/any unauthorized changes are made to the site/any unauthorized changes are made in the installation of the system. Improvement Permit with plat valid without expiration. Improvement Permit with site plan valid for sixty months. Authorization to Construct is valid for a period equal to that of Improvement Permit – not to exceed sixty months.

Signed: Kenneth Watt date 6-1-05 Installed by: DAVID YOUNTZ

Improvement Permit by: STEVE HEDRICK date 6-1-05 Operation Permit by: [signature] date 11-5-07

Authorization to Construct by: STEVE HEDRICK date 6-1-05 Existing System Inspection by: ____ date ____

HEALTH DEPT. COPY: WHITE OWNER COPY (FINAL): YELLOW OWNER COPY (INITIAL): PINK