IREDELL COUNTY HEALTH DEPARTMENT

STATESVILLE 704-878-5305 CI MOORESVILLE 704-664-5281

IMPROVEMENT PERMIT / AUTHORIZATION TO CONSTRUCT / OPERATION PERMIT / EXISTING SYSTEM INSPECTION

PERMIT# 127463 PIN# 4766-75-3586 DATE 5-18-05

OWNER OR CONTRACTOR KENNETH A. WATT PHONE: Business 704-902-4495 Home

ADDRESS 129 BECKHAM ROAD, STATESVILLE, NC 28625

LOCATION OLD MOCKSVILLE ROAD, TR CHESTNUT GROVE RD, TR 1ST SEVEN SPRINGS LOOP 2ND LOT ON LEFT

SUBDIVISION SEVEN SPRINGS BLOCK / SECTION I LOT 55 LOT AREA 0.7748 ACRE SITE CLASS. PS DESIGN FLOW 360 L.T.A.R. 0.30 GPD/FT²

Septic Tank: 1000 Gallons; STB 1012 Date 8-9-04

Pump Tank: ____ Gallons; PT ____ Date ____

Pump Make: ____ Model ____ Serial No. ____

Nitrification Field: No Fields 1 Square Feet EQ-T/200 Linear Feet 300

No Lines FOUR Trench Width 36" Max Trench Bottom Depth 36" Gravel Depth N/A

☑ New System ☐ Repair System Type: I, II, III, IV, V, VI

System Description: 25% REDUCTION, GRAVITY

Repair System Description: CONVENTIONAL, PUMP

Maintenance Agreement Required: ☐ Yes ☑ No

☑ House/Mod. Home No. Bedrooms 3

☐ Mobile Home No. Bathrooms ____

☐ Business No. Employees ____

☐ Other ____

☐ Slab ☑ Crawl Space ☐ Basement w/plumbing ☐ Basement wo/plumbing


Water Supply: ☐ Individual ☑ Public ☐ Community

Comments:/Conditions: INSTALL 25% REDUCTION SYSTEM ON CONTOUR AS FLAGGED. (ACCEPTED SYSTEM)


Comments:/Conditions:

Yellow Filter
No Risers w ST Marker

INITIAL SITE SKETCH SCALE: 1"=40'

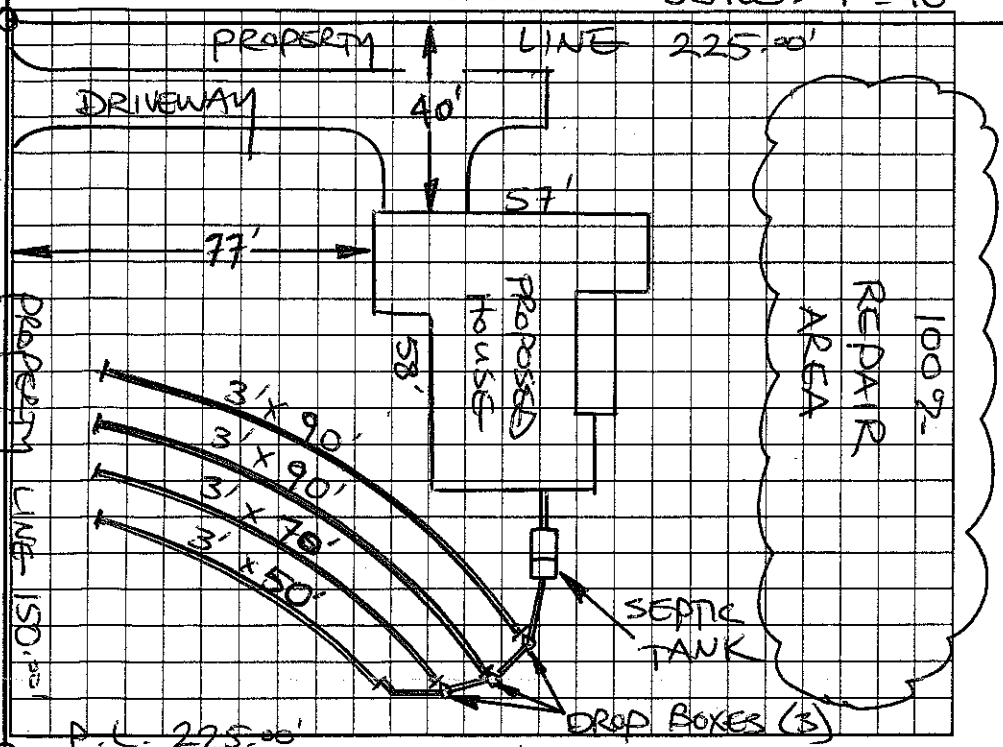

AS BUILT SKETCH

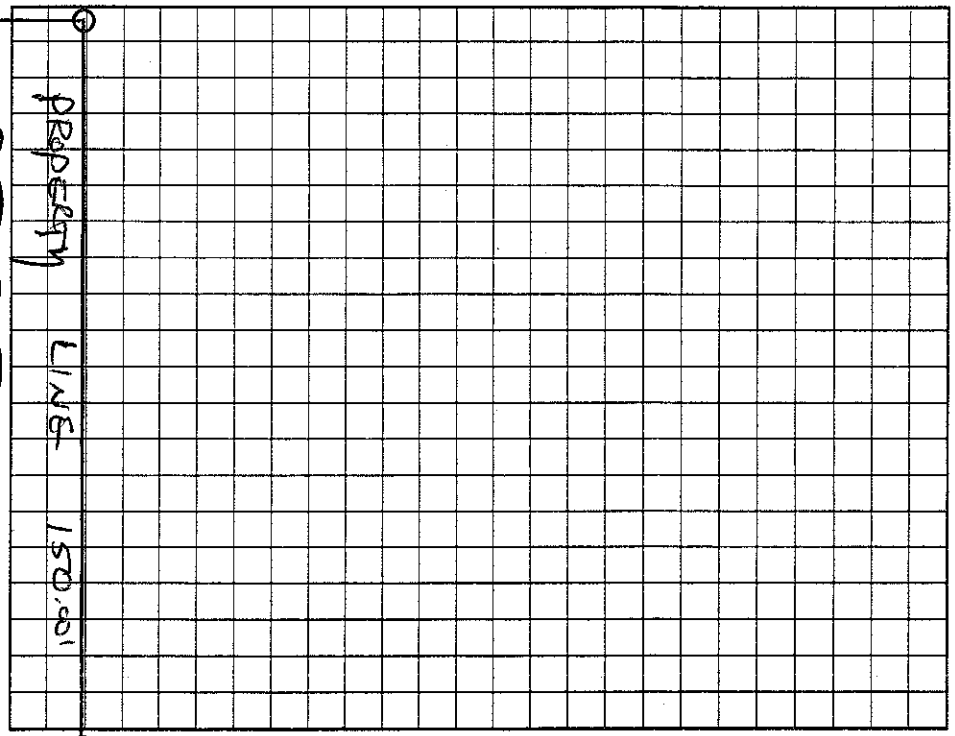

Permit can be suspended or revoked if any false information is supplied toward securing the permit/any unauthorized changes are made to the site/any unauthorized changes are made in the installation of the system. Improvement Permit with plat valid without expiration. Improvement Permit with site plan valid for sixty months. Authorization to Construct is valid for a period equal to that of Improvement Permit – not to exceed sixty months.

Signed: Kenneth A Watt date 5-18-0, Installed by: David Hunter

Improvement Permit by: STEVE HEDRICK date 5-18-05 Operation Permit by: James Hunter date 12-20-05

Authorization to Construct by: STEVE HEDRICK date 5-18-05 Existing System Inspection by: ____ date ____

HEALTH DEPT. COPY: WHITE OWNER COPY (FINAL): YELLOW OWNER COPY (INITIAL): PINK