IREDELL COUNTY HEALTH DEPARTMENT

STATESVILLE 704-878-5305 (C1) MOORESVILLE 704-664-5281

IMPROVEMENT PERMIT / AUTHORIZATION TO CONSTRUCT / OPERATION PERMIT / EXISTING SYSTEM INSPECTION

(C1)

PERMIT# 117974 PIN# 4766-75-6005 DATE 1-22-04

OWNER OR CONTRACTOR ART McKINNEY PHONE: Business Home 704-880-5845

ADDRESS 139 GRANDVIEW DR STATESVILLE NC 28677

LOCATION OLD MOCKSVILLE ROAD NE, TR CHESTNUT GROVE RD, TR 2ND SEVEN SPRINGS LOOP, 1ST LOT ON RIGHT

SUBDIVISION SEVEN SPRINGS BLOCK / SECTION LOT 96 LOT AREA 0.7748 ACRE SITE CLASS. PS DESIGN FLOW 360 L.T.A.R. 0.30 GPD/FT2

Septic Tank: 1000 Gallons; STB 794 Date 3-6-04
Pump Tank: Gallons; PT Date
Pump Make: Model Serial No.
Nitrification Field: No Fields 1 Square Feet 1200 Linear Feet 400
No Lines FOUR Trench Width 36" Max Trench Bottom Depth 36" Gravel Depth 12"

☑ New System ☐ Repair System Type: I, II, III, IV, V, VI
System Description: CONVENTIONAL, GRAVITY
Repair System Description: CONVENTIONAL, GRAVITY
Maintenance Agreement Required: ☐ Yes ☑ No


☑ House/Mod. Home No. Bedrooms 3
☐ Mobile Home No. Bathrooms 2
☐ Business No. Employees
☐ Other
☐ Slab ☑ Crawl Space ☐ Basement w/plumbing ☐ Basement wo/plumbing

Water Supply: ☐ Individual ☑ Public ☐ Community


Comments:/Conditions:

Comments:/Conditions:
Blue Poly/Lok Filter Installed + S.T. Risers
1,2,3rd line Okay 7/22/04

INITIAL SITE SKETCH SCALE: 1" = 40'

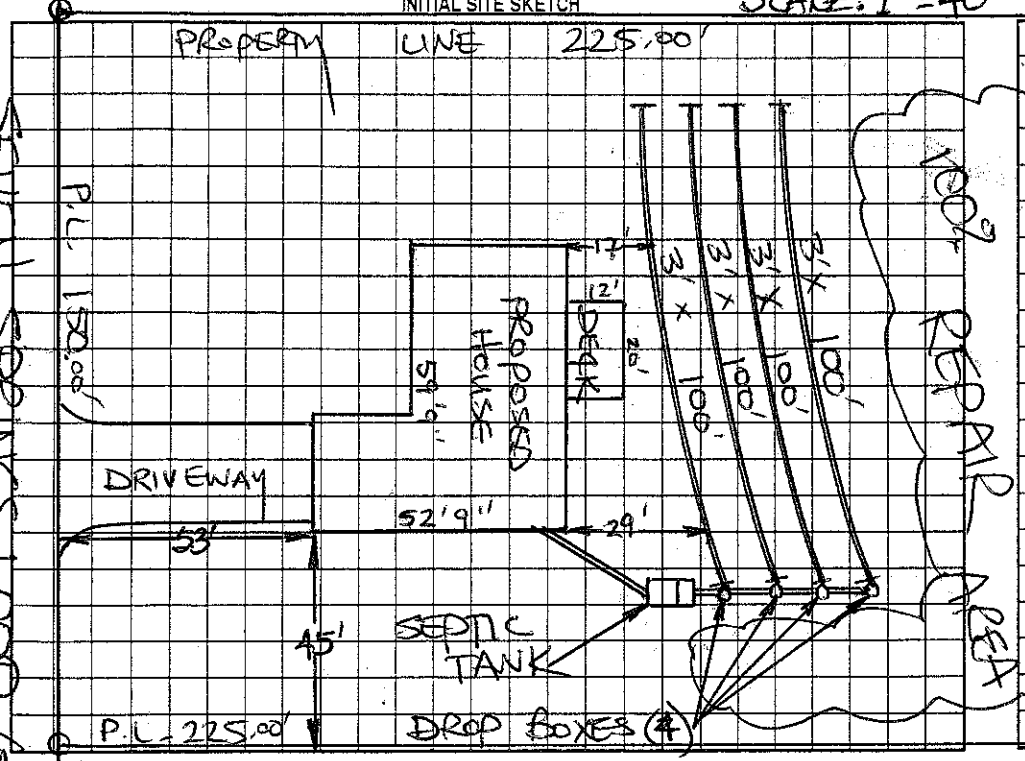

AS BUILT SKETCH

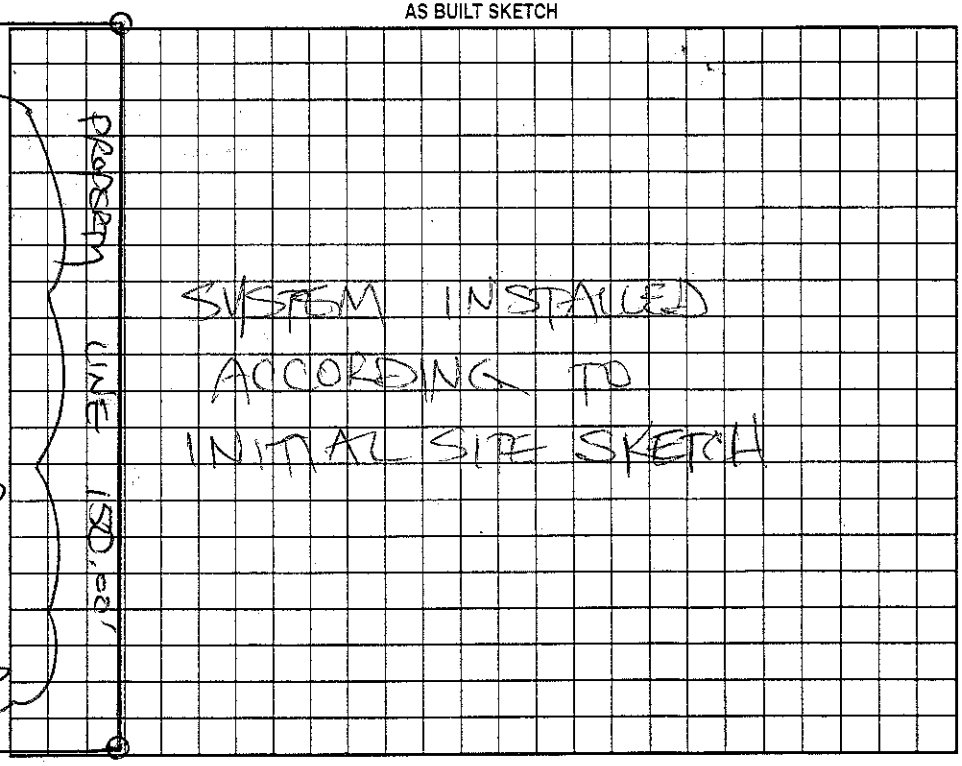

Permit can be suspended or revoked if any false information is supplied toward securing the permit/any unauthorized changes are made to the site/any unauthorized changes are made in the installation of the system. Improvement Permit with plat valid without expiration. Improvement Permit with site plan valid for sixty months. Authorization to Construct is valid for a period equal to that of Improvement Permit – not to exceed sixty months.

Signed: [signature] date 1-22-04 Installed by: Wes Lytton

Improvement Permit by: STEVE HEDRICK date 1-22-04 Operation Permit by: STEVE HEDRICK date 7-23-04

Authorization to Construct by: STEVE HEDRICK date 1-22-04 Existing System Inspection by: date

HEALTH DEPT. COPY: WHITE OWNER COPY (FINAL): YELLOW OWNER COPY (INITIAL): PINK