IREDELL COUNTY HEALTH DEPARTMENT

STATESVILLE 704-878-5305 MOORESVILLE 704-664-5281

IMPROVEMENT PERMIT / AUTHORIZATION TO CONSTRUCT / OPERATION PERMIT / EXISTING SYSTEM INSPECTION

PERMIT# 78344 PIN# 4766756314 DATE 12-29-98

OWNER OR CONTRACTOR Todd Ellis PHONE: Business 878 6633 Home

ADDRESS 178 Meadow Oaks Dr.

LOCATION Chestnut Grove Rd

SUBDIVISION 7 springs BLOCK / SECTION LOT 98 LOT AREA .178 acres SITE CLASS P3 DESIGN FLOW 360 L.T.A.R. .13

Septic Tank: 1000 Gallons; STB 1012 Date 10-9-99

Pump Tank: Gallons; PT Date

Pump Make: Model Serial No. 400

Nitrification Field: No Fields 1 Square Feet 1200 Linear Feet

No Lines 3 Trench Width 36" Max Trench Bottom Depth 36" Gravel Depth 12"

☑ New System ☐ Repair System Type: ☐ I ☐ III ☐ IV ☐ V ☐ VI

System Description: Conv. Gravity

Repair System Description: " "

Maintenance Agreement Required: ☐ Yes ☑ No

☑ House/Mod. Home No. Bedrooms 3

☐ Mobile Home No. Bathrooms 2

☐ Business No. Employees

☐ Other


☐ Slab ☑ Crawl Space ☐ Basement w/plumbing ☐ Basement wo/plumbing

Water Supply: ☐ Individual ☐ Public ☐ Community


Comments/Conditions

Comments/Conditions

INITIAL SITE SKETCH

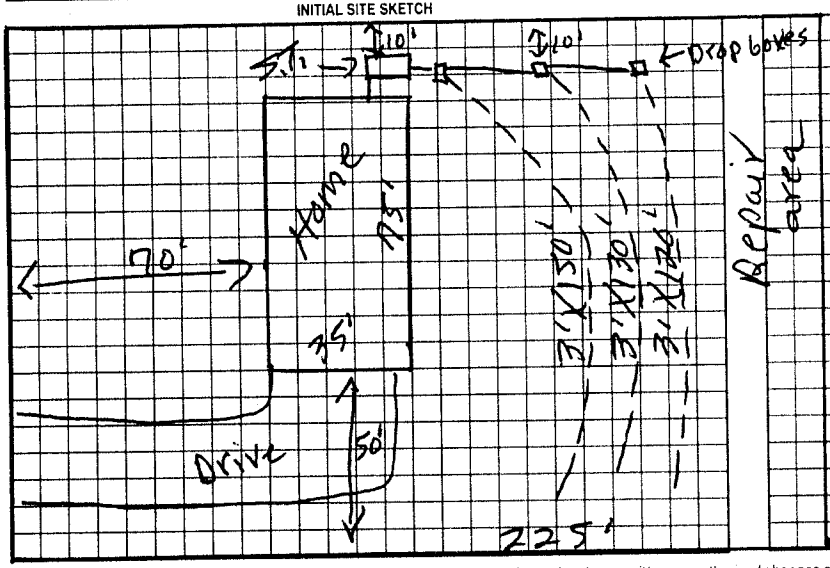

AS BUILT SKETCH

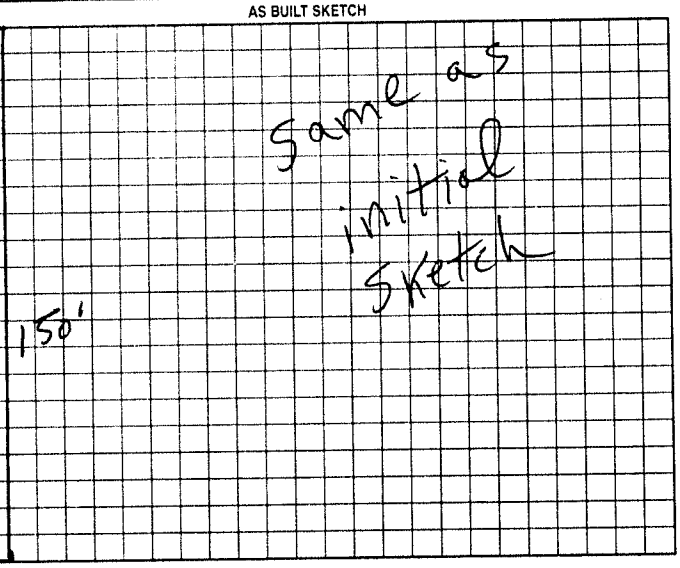

Permit can be suspended or revoked if any false information is supplied toward securing the permit/any unauthorized changes are made to the site/any unauthorized changes are made in the installation of the system. Improvement Permit with plat valid without expiration. Improvement Permit with site plan valid for sixty months. Authorization to Construct is valid for a period equal to that of Improvement Permit -- not to exceed sixty months.

Signed: Todd Ellis date 1-7-99 Installed by: David Younts

Improvement Permit by: E.C. Moore date 12-29-98 Operation Permit by: E.C. Moore date 1-14-00

Authorization to Construct by: E.C. Moore date 12-29-98 Existing System Inspection by: date

HEALTH DEPT COPY WHITE OWNER COPY (FINAL) YELLOW OWNER COPY (INITIAL) PINK