IREDELL COUNTY HEALTH DEPARTMENT

STATESVILLE 704-878-5305 MOORESVILLE 704-664-5281

IMPROVEMENT PERMIT / AUTHORIZATION TO CONSTRUCT / OPERATION PERMIT / EXISTING SYSTEM INSPECTION

PERMIT# 127528 PIN# 4766-75-8471 DATE 6-1-05

OWNER OR CONTRACTOR BOBBY ANDERSON PHONE: Business 704-902-7421 Home 704-546-2273

ADDRESS 239 KINDER ROAD, HARMONY, NC 28634

LOCATION OLD MOCKSVILLE ROAD NE, TR CHESTNUT GROVE ROAD, TR 2ND SEVEN SPRINGS LOOP 2ND LOT ON LEFT

SUBDIVISION SEVEN SPRINGS BLOCK / SECTION 1 LOT 4 LOT AREA 0.775 ACRE SITE CLASS PS DESIGN FLOW 360 L.T.A.R. 0.40 GPD/FT²

Septic Tank: 1000 Gallons; STB 1012 Date 9-18-05

Pump Tank: _____ Gallons; PT _____ Date _____

Pump Make: _____ Model _____ Serial No. _____

Nitrification Field: No Fields 1 Square Feet 1200 Linear Feet 400

No Lines FOUR Trench Width 36" Max Trench Bottom Depth 36" Gravel Depth 12"

☑ New System ☐ Repair System Type: I, II, III, IV, V, VI

System Description: CONVENTIONAL, GRAVITY

Repair System Description: CONVENTIONAL, GRAVITY

Maintenance Agreement Required: ☐ Yes ☑ No

☑ House/Mod. Home No. Bedrooms 3

☐ Mobile Home No. Bathrooms ____

☐ Business No. Employees ____

☐ Other ____

☐ Slab ☑ Crawl Space ☐ Basement w/plumbing ☐ Basement wo/plumbing


Water Supply: ☐ Individual ☑ Public ☐ Community

Comments:/Conditions: AN "ACCEPTED" SYSTEM MAY ALSO BE USED. INSTALL LINES ON CONTOUR.

Comments:/Conditions: Yellow Jeff Tate Septic tank mark

SCALE: 1" = 40'

INITIAL SITE SKETCH

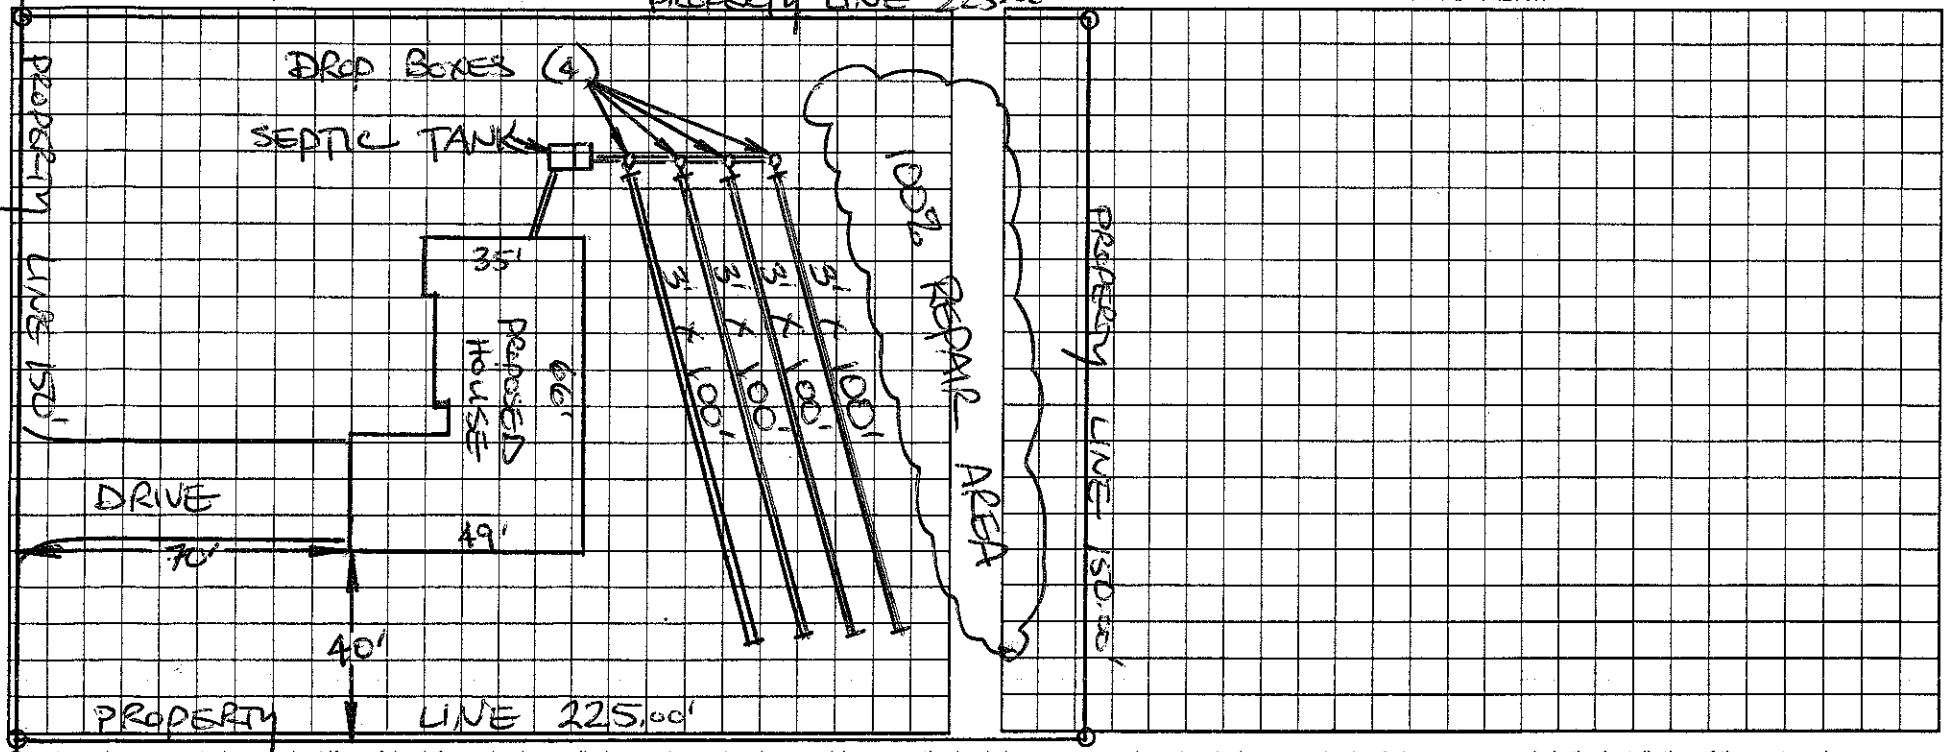

AS BUILT SKETCH

Permit can be suspended or revoked if any false information is supplied toward securing the permit/any unauthorized changes are made to the site/any unauthorized changes are made in the installation of the system. Improvement Permit with plat valid without expiration. Improvement Permit with site plan valid for sixty months. Authorization to Construct is valid for a period equal to that of Improvement Permit – not to exceed sixty months.

Signed: Bobby Anderson date 6-3-05 Installed by: Tommy Tuttle

Improvement Permit by: STEVE HEDRICK date 6-1-05 Operation Permit by: Kelly Cook date 5-2 06

Authorization to Construct by: STEVE HEDRICK date 6-1-05 Existing System Inspection by: _____ date _____

HEALTH DEPT. COPY: WHITE OWNER COPY (FINAL): YELLOW OWNER COPY (INITIAL): PINK