IREDELL COUNTY HEALTH DEPARTMENT

STATESVILLE 704-878-5305 MOORESVILLE 704-664-5281

IMPROVEMENT PERMIT / AUTHORIZATION TO CONSTRUCT / OPERATION PERMIT / EXISTING SYSTEM INSPECTION

PERMIT# 132614 PIN# 4766258680 DATE 12-7-05

OWNER OR CONTRACTOR R&L Construction LLC PHONE: Business 704-880-5219 Home

ADDRESS 120 White Dogwood Lane

LOCATION Old Mocksville RD. to Mount Grove Rd 2nd TSpring loop 1st right on left

SUBDIVISION TSprings BLOCK / SECTION I LOT 3 LOT AREA SITE CLASS. 5 DESIGN FLOW 360 L.T.A.R. B

Septic Tank: 1000 Gallons; STB 1012 Date 8205

Pump Tank: Gallons; PT Date

Pump Make: Model Serial No.

Nitrification Field: No Fields Square Feet 1200 Linear Feet 300

No Lines 3 Trench Width 36" Max Trench Bottom Depth 36" Gravel Depth

☑ New System ☐ Repair System Type: I, II, III, IV, V, VI

System Description: 25% Capacity

Repair System Description 25% Capacity

Maintenance Agreement Required: ☐ Yes ☐ No

☑ House/Mod. Home No. Bedrooms 3

☐ Mobile Home No. Bathrooms

☐ Business No. Employees

☐ Other


☐ Slab ☐ Crawl Space ☐ Basement w/plumbing ☐ Basement wo/plumbing

Water Supply: ☐ Individual ☑ Public ☐ Community

Comments:/Conditions:

Comments:/Conditions: Install on contour maintain all setbacks Surface Filter Septic tank Pump

INITIAL SITE SKETCH

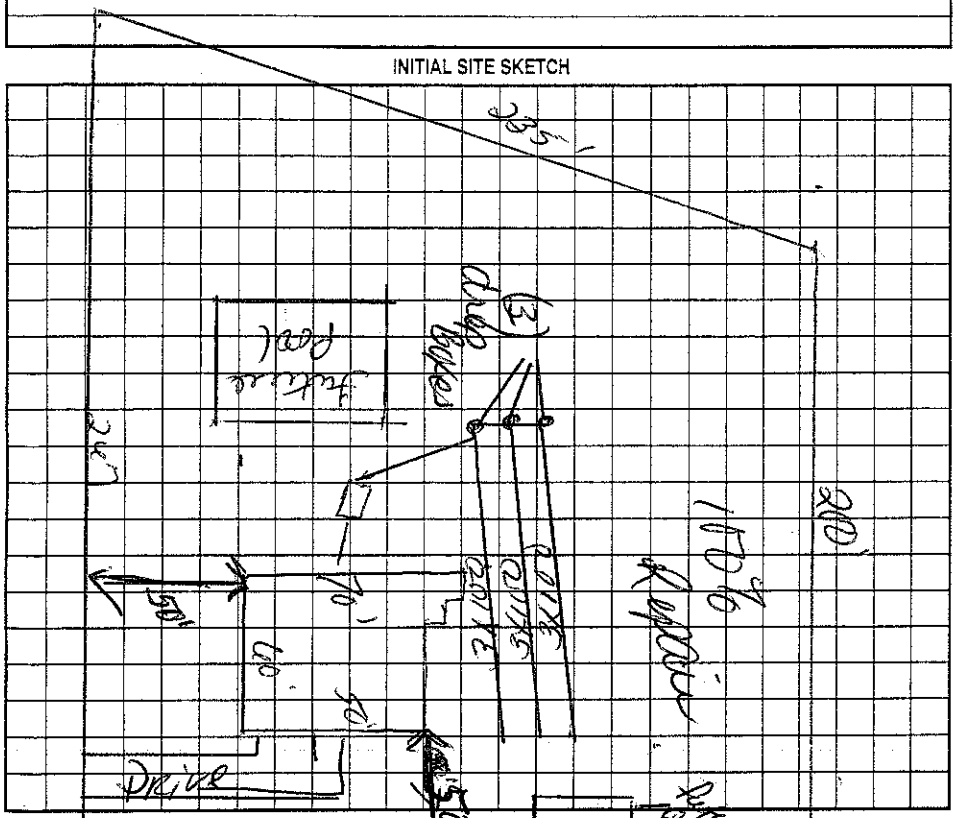

AS BUILT SKETCH

Permit can be suspended or revoked if any false information is supplied toward securing the permit/any unauthorized changes are made to the site/any unauthorized changes are made in the installation of the system. Improvement Permit with plat valid without expiration. Improvement Permit with site plan valid for sixty months. Authorization to Construct is valid for a period equal to that of Improvement Permit – not to exceed sixty months.

Signed: Ron Wilson date

Installed by: Steve Foden

Improvement Permit by: Kelly Cook date 12-7-05

Operation Permit by: Kelly Cook date 3-24-06

Authorization to Construct by: Kelly Cook date 12-7-05

Existing System Inspection by: date

HEALTH DEPT. COPY: WHITE OWNER COPY (FINAL): YELLOW OWNER COPY (INITIAL): PINK