IREDELL COUNTY HEALTH DEPARTMENT

STATESVILLE 704-878-5305 MOORESVILLE 704-664-5281

IMPROVEMENT PERMIT / AUTHORIZATION TO CONSTRUCT / OPERATION PERMIT / EXISTING SYSTEM INSPECTION

PERMIT# 75912 PIN# 4766 831195 DATE 10/5/00

OWNER OR CONTRACTOR DERICK OAVES PHONE: Business Home

ADDRESS 216 HARRELL ST STATESVILLE

LOCATION CHESTNUT GROVE RD - TR SEVEN SPRINGS LOOP - ON LT

SUBDIVISION SEVEN SPRINGS BLOCK / SECTION LOT 21 LOT AREA .75AC SITE CLASS AS DESIGN FLOW 480GPD L.T.A.R. .3 gpd/ft²

Septic Tank: 1000 Gallons: STB 620 Date 9-25-00
Pump Tank: Gallons: PT Date
Pump Make: Model Serial No
Nitrification Field: No Fields 1 Square Feet 533 Linear Feet 270
No Lines 6@45' Trench Width 24" Max Trench Bottom Depth 36" Gravel Depth N/A

☒ New System ☐ Repair System Type: I, II, (III), IV, V, VI
System Description: GRAVITY PANEL
Repair System Description: LPP PANEL
Maintenance Agreement Required: ☐ Yes ☒ No

☒ House/Mod. Home No. Bedrooms 4
☐ Mobile Home No. Bathrooms 3
☐ Business No Employees
☐ Other


☐ Slab ☒ Crawl Space ☐ Basement w/plumbing ☐ Basement wo/plumbing

Water Supply: ☐ Individual ☒ Public ☐ Community

Comments/Conditions:


1"=50'

INITIAL SITE SKETCH

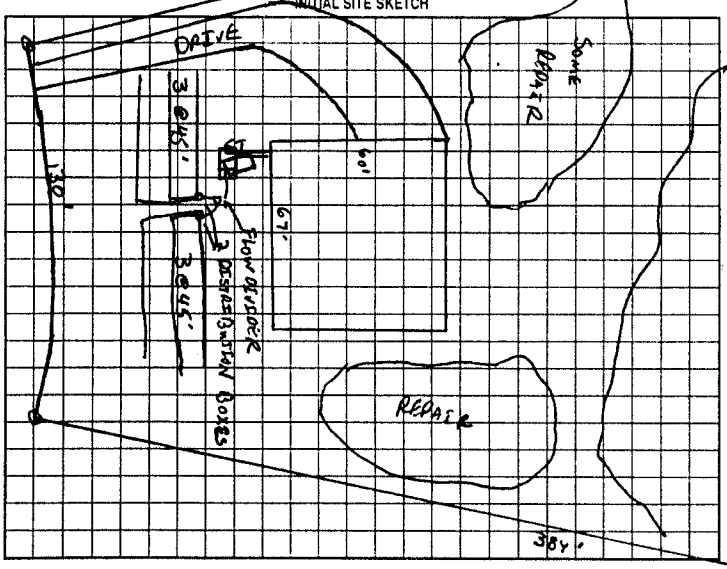

Comments/Conditions: ① SEPTIC TANK WITH RISERS AND MARKER INSTALLED USING "POLYLOK" FILTER ② SYSTEM SIZED TO ACCOMODATE 4 BEDROOMS ONLY ③ SOIL WETNESS CONDITIONS NOTED IN TRENCH BOTTOMS.

AS BUILT SKETCH

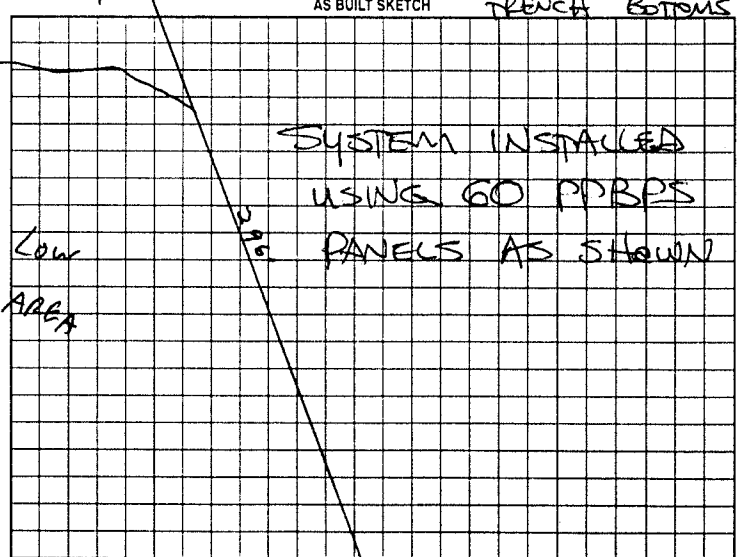

Permit can be suspended or revoked if any false information is supplied toward securing the permit/any unauthorized changes are made to the site/any unauthorized changes are made in the installation of the system. Improvement Permit with plat valid without expiration. Improvement Permit with site plan valid for sixty months. Authorization to Construct is valid for a period equal to that of Improvement Permit - not to exceed sixty months.

Signed: date

Improvement Permit by: C. Bly Fenn RS date 10/5/00

Authorization to Construct by: C. Bly Fenn RS date 10/5/00

Installed by: SAMMY REAVIS

Operation Permit by: STEVE HENDRICK date 11-6-00

Existing System Inspection by: date

HEALTH DEPT. COPY. WHITE OWNER COPY (FINAL). YELLOW OWNER COPY (INITIAL). PINK