IREDELL COUNTY HEALTH DEPARTMENT

STATESVILLE 704-878-5305 MOORESVILLE 704-664-5281

IMPROVEMENT PERMIT / CERTIFICATE OF COMPLETION / OPERATION PERMIT / EXISTING SYSTEM INSPECTION

PROPERTY DESCRIPTION NO. ~~25 & 1105041~~ DATE 12-18-96 TAX MAP NO. 11E-A-98 Watershed: ☐ Yes ☒ No

OWNER OR CONTRACTOR Rex + Karen Johnston PHONE: Business _____ Home 881 0073

ADDRESS 116 Peacock Hollar Statesville, N.C.

LOCATION 64E TL Rivershill on left before East Iredell middle school

SUBDIVISION _____ BLOCK / SECTION _____ LOT _____ LOT AREA 15.34 acres SITE CLASS. PS DESIGN FLOW 360 L.T.A.R. .28

Septic Tank: 1000 Gallons; STB 1012 Date 3-10-97

Pump Tank: _____ Gallons; PT _____ Date _____

Pump Make: _____ Model _____ Serial No. _____

Nitrification Field: No Fields 1 Square Feet 1350 Linear Feet 450

No Lines 3 Trench Width 36" Max Trench Bottom Depth 36" Gravel Depth 12"

☒ New System ☐ Repair System Type: I, (II), III, IV, V, VI

System Description: Conv. Gravity

Repair System Description: " "

Maintenance Agreement Required: ☐ Yes ☒ No

☐ House/Mod. Home No. Bedrooms 3

☒ Mobile Home No. Bathrooms 2

☐ Business No. Employees _____

☐ Other _____


☐ Slab ☒ Crawl Space ☐ Basement w/plumbing ☐ Basement wo/plumbing

Water Supply: ☒ Individual ☐ Community ☐ Public


Comments:

Comments:

INITIAL SITE SKETCH

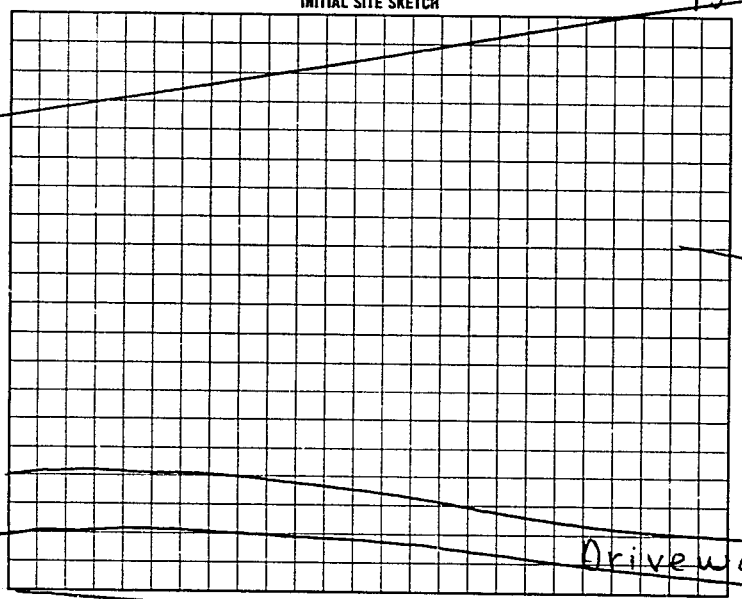

AS BUILT SKETCH

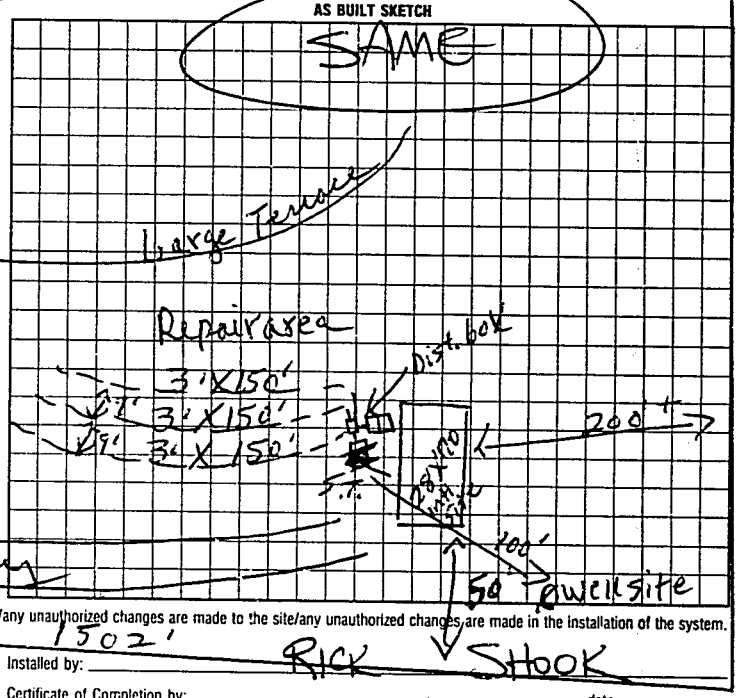

I understand that this permit can be ~~suspended or~~ revoked if any false information is supplied toward securing the permit/any unauthorized changes are made to the site/any unauthorized changes are made in the installation of the system. Improvement Permit is valid for 60 months from date of issuance.

Signed: X Rex Johnston

Improvement Permit by: L. C. Moore date 12-18-96

~~Existing System Inspected by~~ Authorization to Cover: L. C. Moore date 12-18-96

Installed by: _____

Certificate of Completion by: _____ date _____

Operation Permit by STEVE HENDRICK date 5-8-97

Authorization to Const. EXPIRES 60 mos from issue

HEALTH DEPT. COPY: WHITE INSPECTION COPY (FINAL): GREEN OWNER COPY (FINAL): YELLOW INSPECTION COPY (INITIAL): PINK OWNER COPY (INITIAL): GOLD

9211 00