PIN #4766-94-0948

IREDELL COUNTY HEALTH DEPARTMENT - *ENVIRONMENTAL HEALTH* ☒ STATESVILLE OFFICE 704-878-5305 ☐ MOORESVILLE OFFICE 704-664-5281

IMPROVEMENT PERMIT / AUTHORIZATION TO CONSTRUCT / OPERATION PERMIT / EXISTING SYSTEM INSPECTION

PERMIT # 168499 PIN # (From 4766-85-9070) new # DATE 9-19-11

OWNER Jerry Campbell APPLICANT: Freedom Home PHONE: Home/Cell # 704-883-2440 Business #

SITE ADDRESS 542 Chestnut Grove Rd OWNER/APPLICANT ADDRESS 134 Forney

SITE DIRECTIONS Hwy 21N, (R) Jane Sowers, (L) Old Mocksville, (R) Chestnut Grove Rd, prop on L before School

SUBDIVISION R.C. Campbell's Family BLOCK / SECTION LOT # 5 LOT AREA DESIGN FLOW 480 L.T.A.R. .3

Septic Tank 1000 Gallons: STB 760 Date 5-9-11
Pump Tank Gallons: P T Date
Pump Make Model Serial #
No. Nitrification Fields: 1 No. Lines 5 Linear Feet 400
Trench Width 36" Max. Trench Bottom Depth 36" Gravel Depth n/a


☐ New System ☐ Repair ☐ Expansion System Type I II (III) IV V VI
System Description: 25% Reduction Gravity
Repair System Description: 50% Reduction LP
Maintenance Agreement Required ☐ YES ☒ NO
☒ GRAVITY ☐ PRESSURE

☒ Residence No. Bedrooms 4
☐ Business No. Persons
☐ Other No. Employees
☐ Slab ☒ Crawl Space
☐ Basement w/plumbing ☐ Basement w/o plumbing


Water Supply: ☐ Private ☒ Public ☐ Community

Comments / Conditions: Plat of new parcel must be recorded before CA is issued. IP dependent of new parcel being recorded as shown on attached proposed plat

INITIAL SITE SKETCH

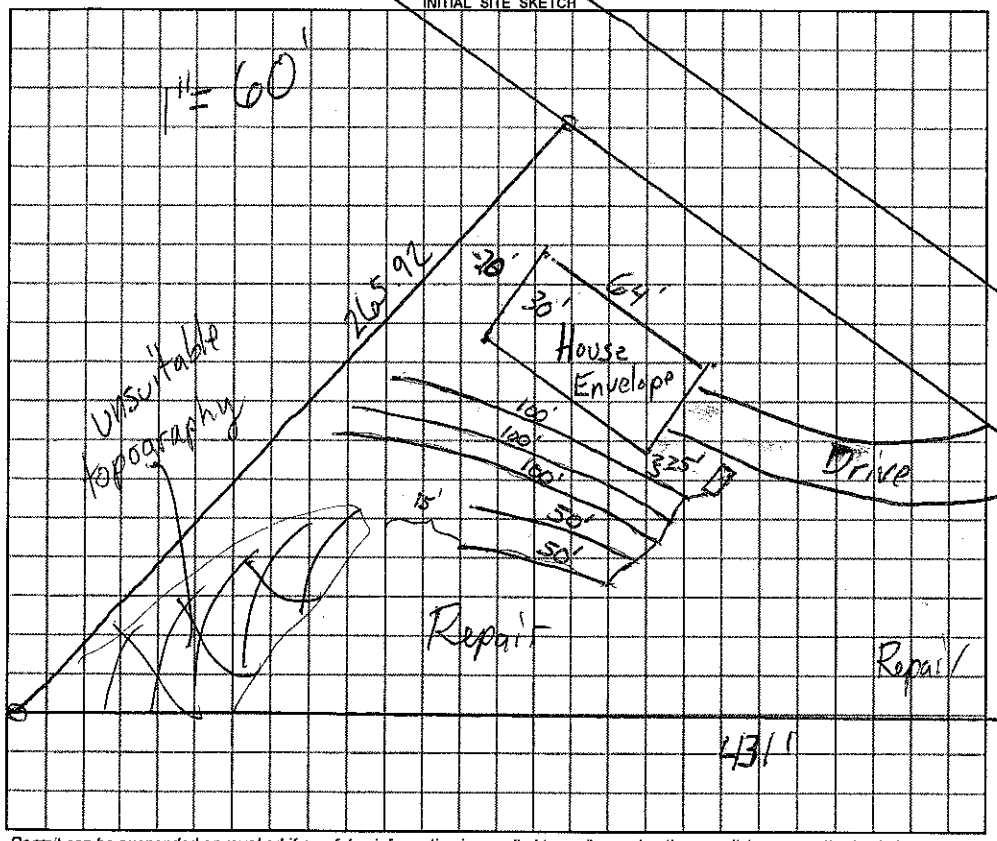

AS BUILT SKETCH

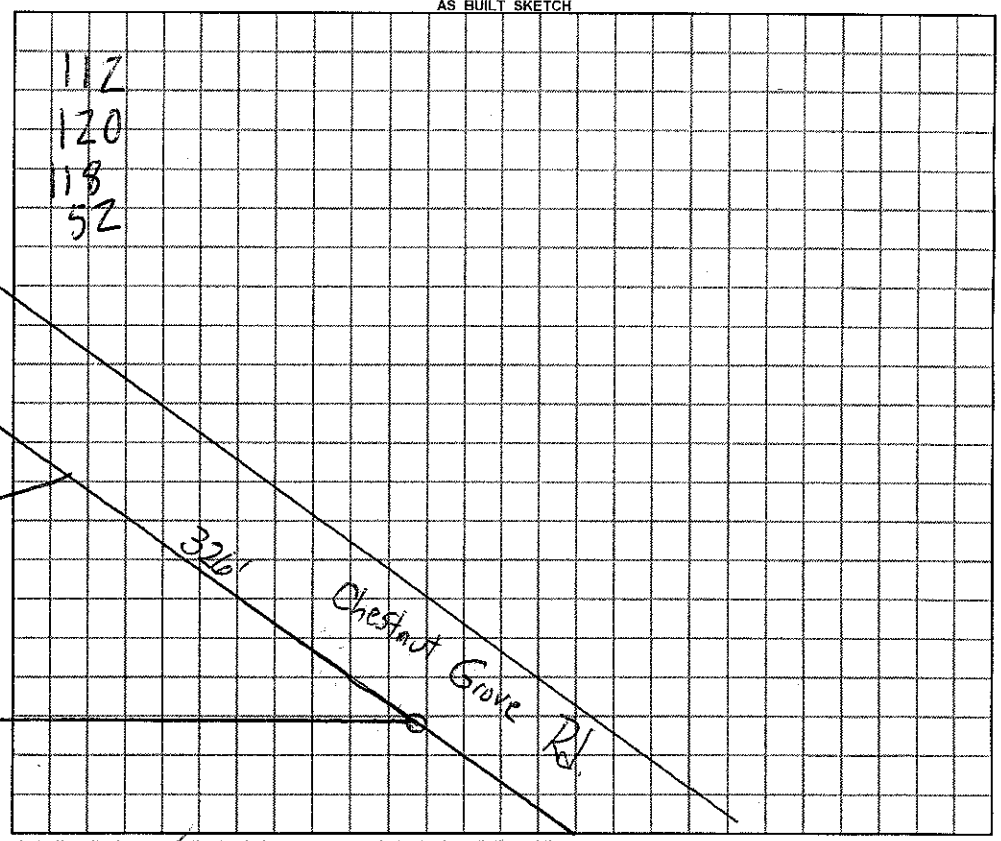

Permit can be suspended or revoked if false information is supplied toward securing the permit / any unauthorized changes are made to the site / any unauthorized changes are made in the installation of the system.

☐ ***IMPROVEMENT PERMIT*** with plat valid without expiration. ☑ ***IMPROVEMENT PERMIT*** with plat valid without expiration, site plan valid 60 mo. ☑ ***AUTHORIZATION TO CONSTRUCT*** valid for period equal to IMPROVEMENT PERMIT--not to exceed 60 mo.

Owner / Applicant Signature: Eric Ward Date 9-20-11 Installed by: A-1 Backhoe

IMPROVEMENT PERMIT by: REHS Date 9-19-11 OPERATION PERMIT by: REHS Date 9-30-11

AUTHORIZATION TO CONSTRUCT by: REHS Date 9-20-11 Existing System Inspected by: REHS Date

YOU SHOULD CONTACT A LOCATOR SERVICE PRIOR TO ANY EXCAVATION

White Copy – Environmental Health YELLOW COPY (Final) Owner / Applicant PINK COPY (Initial) Owner / Applicant