pd 1/25 #-2698

IREDELL COUNTY HEALTH DEPARTMENT

STATESVILLE 704-878-5305 MOORESVILLE 704-664-5281

IMPROVEMENT PERMIT / AUTHORIZATION TO CONSTRUCT / OPERATION PERMIT / EXISTING SYSTEM INSPECTION

PERMIT# 071149 PIN# 4766 95 9764 DATE 1-20-98

OWNER OR CONTRACTOR G & G PROPERTIES PHONE: Business 873-1481 (OTMH) Home 873-4427 (KEN WEBB)

ADDRESS P.O. BOX 6386, STATESVILLE, NC 28677

LOCATION OLD MOCKSVILLE RD NE, TR CHESTNUT GROVE RD, TL EASTGATE DRIVE, 1ST LOT ON LEFT

SUBDIVISION EASTGATE ESTATES BLOCK / SECTION ____ LOT 1 LOT AREA LIMITED SITE CLASS. PS DESIGN FLOW 360 L.T.A.R. 0.30 GPD/FT²

Septic Tank: 1000 Gallons; STB 1012 Date 10-27-98
Pump Tank: ____ Gallons; PT ____ Date ____
Pump Make: ____ Model ____ Serial No. ____
Nitrification Field: No Fields 1 Square Feet EQ. TO 1200 Linear Feet 300+
No Lines FIVE Trench Width 36" Max Trench Bottom Depth 36" Gravel Depth SAME 6"

☑ New System ☐ Repair System Type: I, II, III, IV, V, VI
System Description: CHAMBERED GRAVITY
Repair System Description: PPBPS LPP
Maintenance Agreement Required: ☐ Yes ☑ No

☐ House/Mod. Home ☑ Mobile Home ☐ Business ☐ Other
No. Bedrooms 3 No. Bathrooms 2 No. Employees ____


☐ Slab ☑ Crawl Space ☐ Basement w/plumbing ☐ Basement wo/plumbing

Water Supply: ☐ Individual ☑ Public ☐ Community

Comments/Conditions: ① INSTALL FIFTY CHAMBERS IN FIVE EQUAL LENGTH LINES ON CONTOUR AS SHOWN ② NO VEHICULAR TRAFFIC ALLOWED OVER SYSTEM

Comments/Conditions:

INITIAL SITE SKETCH

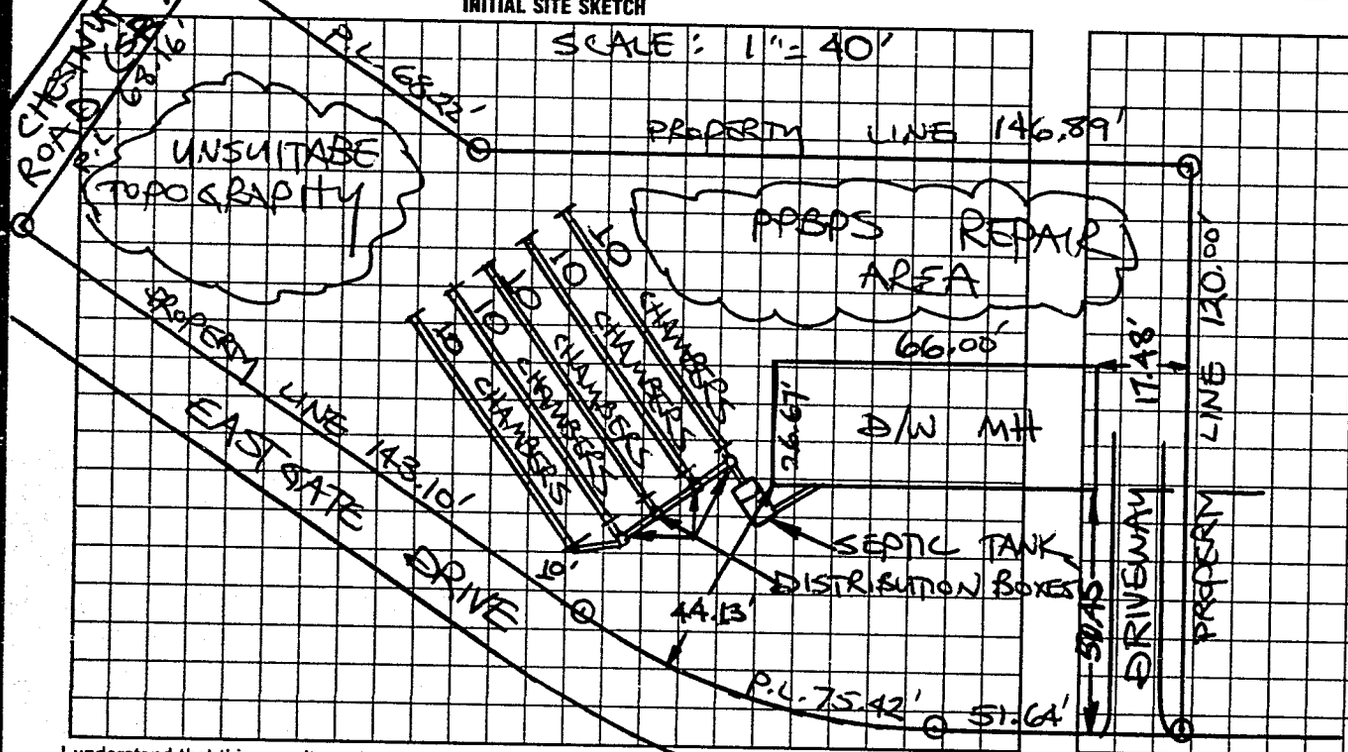

AS BUILT SKETCH

SYSTEM INSTALLED ACCORDING TO INITIAL SITE SKETCH

I understand that this permit can be suspended or revoked if any false information is supplied toward securing the permit/any unauthorized changes are made to the site/any unauthorized changes are made in the installation of the system. Improvement Permit with plat valid without expiration. Improvement Permit with site plan valid for sixty months. Authorization to Construct is valid for a period equal to that of Improvement Permit – not to exceed sixty months.

Signed: [signature] date ____

Improvement Permit by: STEVE HEDRICK date 1-20-98

Authorization to Construct by: STEVE HEDRICK date 1-20-98

Installed by: A-1 BACKHOE

Operation Permit by: STEVE HEDRICK date 2-19-98

Existing System Inspection by: ____ date ____

HEALTH DEPT. COPY: WHITE INSPECTION COPY (FINAL): GREEN OWNER COPY (FINAL): YELLOW INSPECTION COPY (INITIAL): PINK OWNER COPY (INITIAL): GOLD