This Permit Voids Previous issued 4-26-00

IREDELL COUNTY HEALTH DEPARTMENT

STATESVILLE 704-878-5305 MOORESVILLE 704-664-5281

IMPROVEMENT PERMIT / AUTHORIZATION TO CONSTRUCT / OPERATION PERMIT / EXISTING SYSTEM INSPECTION

PERMIT# 89139 PIN# 4766958014 DATE May 18 2000

OWNER OR CONTRACTOR Stikeleather & Association PHONE: Business Home 876-6847

ADDRESS P.O. Box 6286 Statesville NC

LOCATION 64E ⓐ Rivershill Rd ⓑ Chestnut Grove ⓒ Eastgate on Left

SUBDIVISION Eastgate BLOCK / SECTION LOT 3 LOT AREA .34Ac SITE CLASS P3 DESIGN FLOW 360 L.T.A.R. .25

Septic Tank: 1000 Gallons; STB 825 Date

Pump Tank: Gallons; PT Date

Pump Make: Model Serial No.

Nitrification Field: No Fields 6 Square Feet 1440 Linear Feet 240

No Lines 6 Trench Width 24" Max Trench Bottom Depth 36" Gravel Depth N/A

☒ New System ☐ Repair System Type: I, II, III, IV, V, VI

System Description: GRAVITY 50% Reduction

Repair System Description: pump to Panels

Maintenance Agreement Required: ☐ Yes ☒ No

☐ House/Mod. Home ☒ Mobile Home DW ☐ Business ☐ Other

No. Bedrooms 3 No. Bathrooms 2 No. Employees

☐ Slab ☒ Crawl Space ☐ Basement w/plumbing ☐ Basement wo/plumbing


Water Supply: ☐ Individual ☒ Public ☐ Community

Comments/Conditions: ① Raise Tank & Reset To insure 36" Trench Depth on drainLines & Check Seal


② Install on contour - 54 Panels 8 Ft Centers 1st & Last Line 11 Panels each As shown Middle 4 Lines 8 Panels each

Comments/Conditions: - Tank Setting on backfill - Installed As shown

INITIAL SITE SKETCH

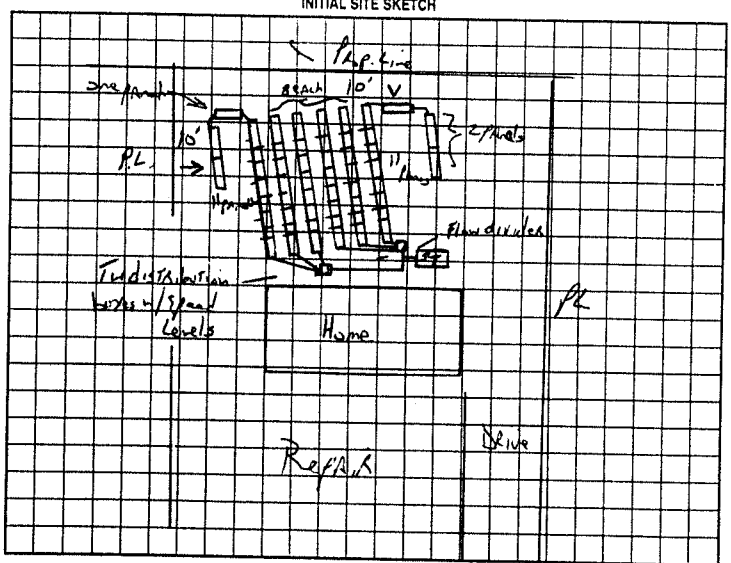

AS BUILT SKETCH

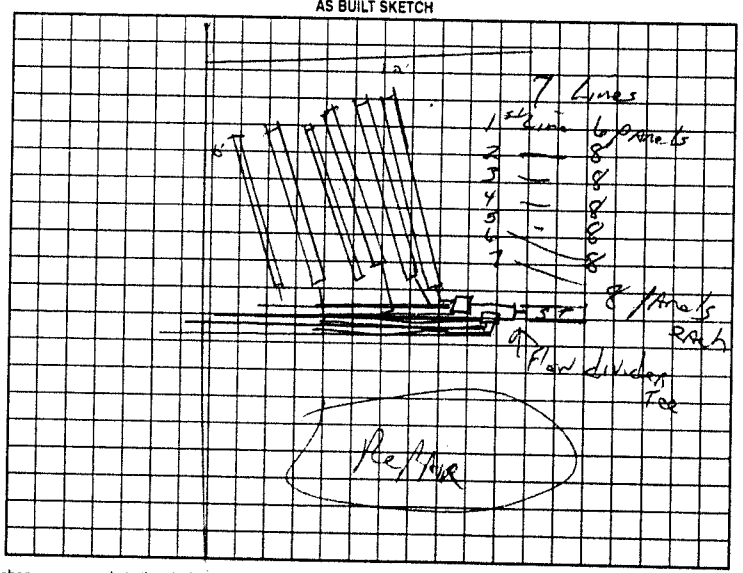

Permit can be suspended or revoked if any false information is supplied toward securing the permit/any unauthorized changes are made to the site/any unauthorized changes are made in the installation of the system. Improvement Permit with plat valid without expiration. Improvement Permit with site plan valid for sixty months. Authorization to Construct is valid for a period equal to that of Improvement Permit – not to exceed sixty months.

Signed: David Allen date 5-18-00 Installed by: C + W

Improvement Permit by: Jc Potter date May 18 2000 Operation Permit by: Jc Potter date May 23 00

Authorization to Construct by: Jc Potter date May 18 2000 Existing System Inspection by: date

HEALTH DEPT. COPY: WHITE OWNER COPY (FINAL): YELLOW OWNER COPY (INITIAL): PINK