pd #25 1-26-98

IREDELL COUNTY HEALTH DEPARTMENT

STATESVILLE 704-878-5305 MOORESVILLE 704-664-5281

IMPROVEMENT PERMIT / AUTHORIZATION TO CONSTRUCT / OPERATION PERMIT / EXISTING SYSTEM INSPECTION

PERMIT# 071577 PIN# 4766 95 9764 DATE 1-21-98

OWNER OR CONTRACTOR G & G PROPERTIES PHONE: Business 873-4427 (NAMC) Home 878-4139

ADDRESS P.O. BOX 6386, STATESVILLE, NC 28687

LOCATION OLD MOCKSVILLE ROAD NE, TR CHESTNUT GROVE ROAD, TL EASTGATE DRIVE, 4TH LOT ON LEFT

SUBDIVISION EASTGATE ESTATES BLOCK / SECTION ____ LOT 4 LOT AREA 15,000 FT² SITE CLASS. PS DESIGN FLOW 360 L.T.A.R. 0.30 GPD/FT²

Septic Tank: 1000 Gallons; STB 1012 Date 10-27-97

Pump Tank: ____ Gallons; PT ____ Date ____

Pump Make: ____ Model ____ Serial No. ____

Nitrification Field: No Fields 1 Square Feet Eq. to 1200 Linear Feet 300'

No Lines FOUR Trench Width 36" Max Trench Bottom Depth 36" ~~Gravel~~ Depth SAND 6"

☑ New System ☐ Repair System Type: I, II, III, IV, V, VI

System Description: CHAMBERED GRAVITY

Repair System Description: CHAMBERED PUMP

Maintenance Agreement Required: ☐ Yes ☑ No

☐ House/Mod. Home ☑ Mobile Home ☐ Business ☐ Other

No. Bedrooms 3 No. Bathrooms 2 No. Employees ____


Water Supply: ☐ Individual ☑ Public ☐ Community

☐ Slab ☑ Crawl Space ☐ Basement w/plumbing ☐ Basement wo/plumbing

Comments:/Conditions: ① INSTALL FIFTY CHAMBERS ON CONTOUR AS SHOWN ② KEEP SYSTEM MINIMUM 10' FROM PROPERTY LINE

Comments:/Conditions: SEPTIC TANK INSTALLED 3" OUT OF LEVEL, UPPER LINES INSTALLED DEEPER THAN 36"

INITIAL SITE SKETCH SCALE: 1" = 40'

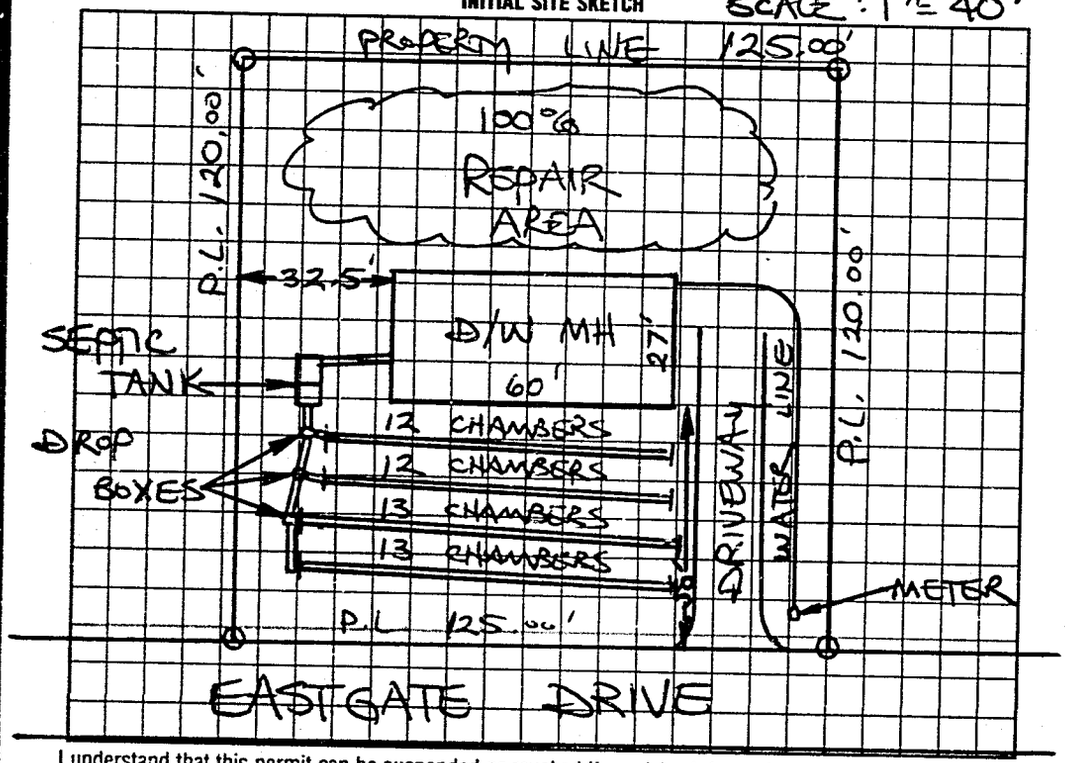

AS BUILT SKETCH

SYSTEM INSTALLED ACCORDING TO INITIAL SITE SKETCH

I understand that this permit can be suspended or revoked if any false information is supplied toward securing the permit/any unauthorized changes are made to the site/any unauthorized changes are made in the installation of the system. Improvement Permit with plat valid without expiration. Improvement Permit with site plan valid for sixty months. Authorization to Construct is valid for a period equal to that of Improvement Permit – not to exceed sixty months.

Signed: Ken Wells date ____

Improvement Permit by: STEVE HEDRICK date 1-21-98

Authorization to Construct by: STEVE HEDRICK date 1-21-98

Installed by: A-1 BACKHOE

Operation Permit by: STEVE HEDRICK date 2-19-98

Existing System Inspection by: ____ date ____

HEALTH DEPT. COPY: WHITE INSPECTION COPY (FINAL): GREEN OWNER COPY (FINAL): YELLOW INSPECTION COPY (INITIAL): PINK OWNER COPY (INITIAL): GOLD