IREDELL COUNTY HEALTH DEPARTMENT

STATESVILLE 704-878-5305 MOORESVILLE 704-664-5281

IMPROVEMENT PERMIT / AUTHORIZATION TO CONSTRUCT / OPERATION PERMIT / EXISTING SYSTEM INSPECTION

PERMIT# 83000 PIN# 4766959764 DATE 8-3-99

OWNER OR CONTRACTOR Stikeleather + assoc. PHONE: Business 876-6847 Home

ADDRESS PO Box 6786 Statesville

LOCATION 64 E TR River Hill TL Chestnut Grove TR Eastgate 5th lot left

SUBDIVISION Eastgate Est BLOCK / SECTION LOT 5 LOT AREA 15,037 sf SITE CLASS P5 DESIGN FLOW 360 L.T.A.R. .3

Septic Tank: 1000 Gallons; STB 825 Date 6-1-99
Pump Tank: Gallons; PT Date
Pump Make: Model Serial No.
Nitrification Field: No Fields 1 Square Feet 400 Linear Feet 200
No Lines 4 Trench Width 36" Max Trench Bottom Depth 36" Gravel Depth


☑ New System ☐ Repair System Type: I. II. III. IV. V. VI
System Description: Gravity Panels
Repair System Description:
Maintenance Agreement Required: ☐ Yes ☑ No

☑ House/Mod. Home No. Bedrooms 3
☐ Mobile Home No. Bathrooms 2
☐ Business No. Employees
☐ Other
☐ Slab ☑ Crawl Space ☐ Basement w/plumbing ☐ Basement wo/plumbing

Water Supply: ☐ Individual ☑ Public ☐ Community

Comments/Conditions:


INITIAL SITE SKETCH

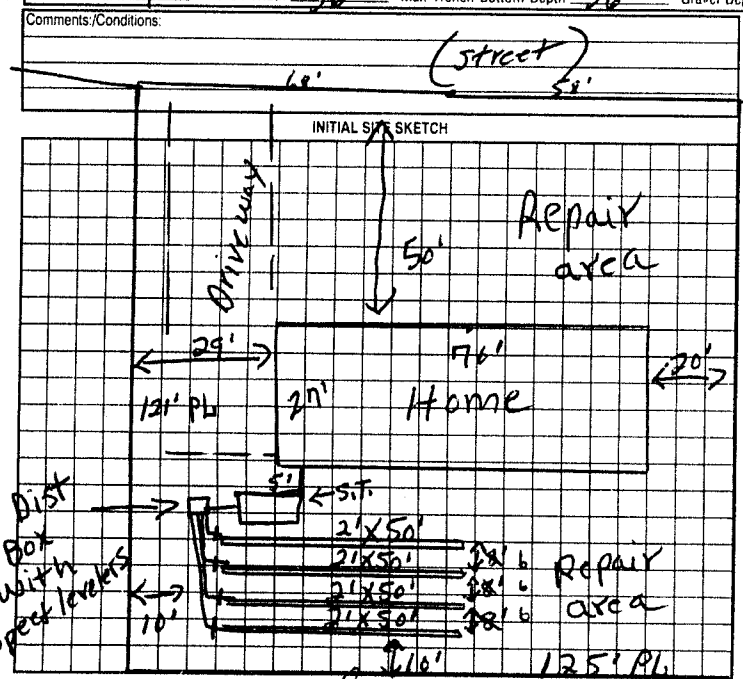

Comments/Conditions:

Lines closer on center to keep off property line per SM.

AS BUILT SKETCH

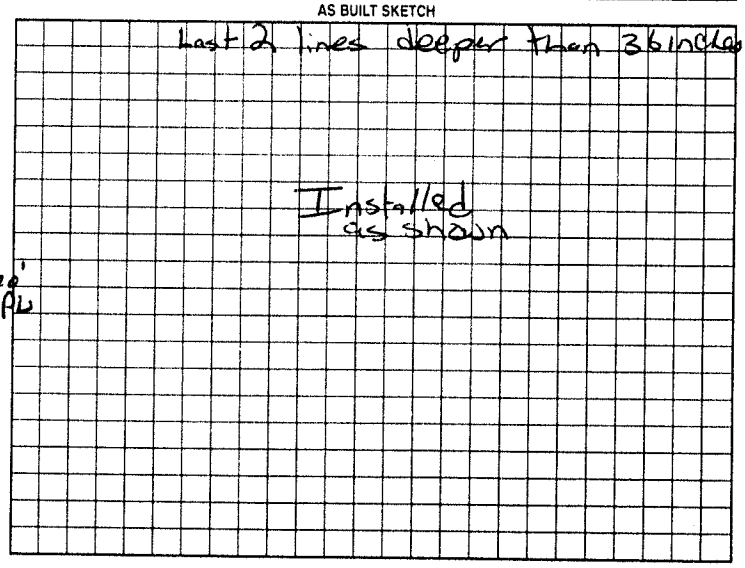

Permit can be suspended or revoked if any false information is supplied toward securing the permit/any unauthorized changes are made to the site/any unauthorized changes are made in the installation of the system. Improvement Permit with plat valid without expiration. Improvement Permit with site plan valid for sixty months. Authorization to Construct is valid for a period equal to that of Improvement Permit – not to exceed sixty months.

Signed: [signature] date 8-11-99 Installed by: B & W

Improvement Permit by: P.C. moore date 8-3-99 Operation Permit by: [signature] date 8-27-99

Authorization to Construct by: P.C. moore date 8-3-99 Existing System Inspection by: date

HEALTH DEPT. COPY. WHITE OWNER COPY (FINAL) YELLOW OWNER COPY (INITIAL) PINK