IREDELL COUNTY HEALTH DEPARTMENT

STATESVILLE 704-878-5305 MOORESVILLE 704-664-5281

CI

IMPROVEMENT PERMIT / AUTHORIZATION TO CONSTRUCT / OPERATION PERMIT / EXISTING SYSTEM INSPECTION

PERMIT# 094406 PIN# 4766958411 DATE 4/3/01

OWNER OR CONTRACTOR G-T-G Properties PHONE: Business (704) 876-6847 Home —

ADDRESS P.O. Box 6296 Statesville NC. 28687

LOCATION Hwy 64 E. (on River Hill Rd) (L) Chestnut Grove Rd. (TR) onto Eastgate Drive 6th lot on Left

SUBDIVISION Eastgate Estate BLOCK / SECTION — LOT #6 LOT AREA 1.35 Ac. SITE CLASS IV DESIGN FLOW 360 L.T.A.R. .35

Septic Tank: 4000 Gallons: STB 1012 Date 12-11-01

Pump Tank: — Gallons: PT — Date —

Pump Make: — Model 7029 Serial No. —

Nitrification Field: No Fields 1 Square Feet 1003 Linear Feet 180

No Lines 4 Trench Width 36 24" Max Trench Bottom Depth 36" Gravel Depth Sand

[X] New System [ ] Repair System Type: I. II (III) IV. V. VI

System Description: Gravity, Panel Block

Repair System Description: Pump, Panel Block

Maintenance Agreement Required: [ ] Yes [X] No

[ ] House/Mod. Home No. Bedrooms 3

[X] Mobile Home No. Bathrooms 2

[ ] Business No. Employees —

[ ] Other —


[ ] Slab [X] Crawl Space [ ] Basement w/plumbing [ ] Basement wo/plumbing

Water Supply: [ ] Individual [X] Public [ ] Community

Comments:/Conditions: ① Do not exceed 2 bedroom Load ② Key System 10 ft from property lines ③ Use 40 Sections of Panel Block for 50% reduction in linear ft. (Sand - 30 ton)

Comments:/Conditions: MARKER @ POLYLOK FILTER INSTALLED AS SHOWN

INITIAL SITE SKETCH Not to Scale

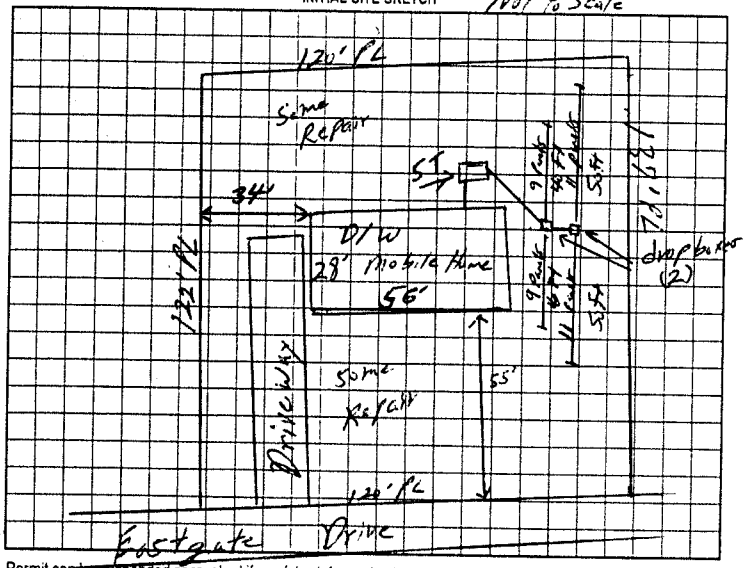

AS BUILT SKETCH

Permit can be suspended or revoked if any false information is supplied toward securing the permit/any unauthorized changes are made to the site/any unauthorized changes are made in the installation of the system. Improvement Permit with plat valid without expiration. Improvement Permit with site plan valid for sixty months. Authorization to Construct is valid for a period equal to that of Improvement Permit – not to exceed sixty months.

Signed: [signature] date 11,20,01 Installed by: GOTHRON BACKHOE

Improvement Permit by: William C. Johnson RSI date 4/3/01 Operation Permit by: [signature] RS date 04-23-02

Authorization to Construct by: William C. Johnson RSI date 4/3/01 Existing System Inspection by: — date —

HEALTH DEPT COPY WHITE OWNER COPY (FINAL) YELLOW OWNER COPY (INITIAL) PINK