IREDELL COUNTY HEALTH DEPARTMENT

STATESVILLE 704-878-5305 MOORESVILLE 704-664-5281

IMPROVEMENT PERMIT / AUTHORIZATION TO CONSTRUCT / OPERATION PERMIT / EXISTING SYSTEM INSPECTION

PERMIT# 80451 PIN# 4766 95 9764 DATE 4-12-99

OWNER OR CONTRACTOR Stikeleather + associates PHONE: Business 876-0180 Home

ADDRESS PO Box 6286 Statesville, N.C.

LOCATION 64E Th Rimshill Rd Th Chestnut Grove Tr Into East Gate 1/4mi Lf

SUBDIVISION Eastgate BLOCK / SECTION LOT 8 LOT AREA 17363 SITE CLASS PS DESIGN FLOW 360 L.T.A.R. .3

Septic Tank: 1000 Gallons; STB 1012 Date 2-29-99?

Pump Tank: Gallons; PT Date

Pump Make: Model Serial No.

Nitrification Field: No Fields 1 Square Feet 900 Linear Feet 300

No Lines 5 Trench Width 36" Max Trench Bottom Depth 36" Gravel Depth N/A

☑ New System ☐ Repair System Type: I, II, III, IV, V, VI

System Description: Gravity 25% Red

Repair System Description: Pump to 25% Red

Maintenance Agreement Required: ☐ Yes ☑ No

☑ House/Mod. Home No. Bedrooms 3

☑ Mobile Home No. Bathrooms 2

☐ Business No. Employees

☐ Other


☐ Slab ☐ Crawl Space ☐ Basement w/plumbing ☐ Basement wo/plumbing

Water Supply: ☐ Individual ☑ Public ☐ Community


Comments:/Conditions:

Comments:/Conditions:

INITIAL SITE SKETCH 162'

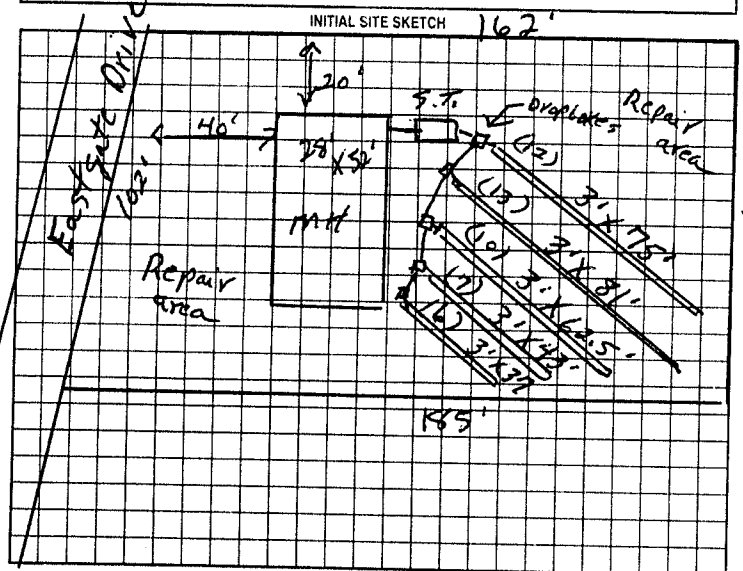

AS BUILT SKETCH

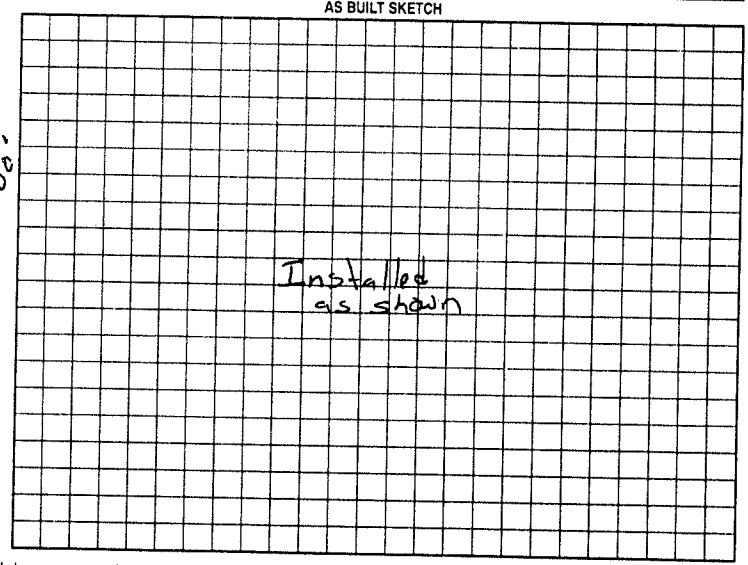

Permit can be suspended or revoked if any false information is supplied toward securing the permit/any unauthorized changes are made to the site/any unauthorized changes are made in the installation of the system. Improvement Permit with plat valid without expiration, Improvement Permit with site plan valid for sixty months. Authorization to Construct is valid for a period equal to that of Improvement Permit – not to exceed sixty months.

Signed: [signature] date 4-16-99 Installed by: C+W Septic

Improvement Permit by: P.C. Moore date 4-12-99 Operation Permit by: Mat Coffey RS date 4-21-99

Authorization to Construct by: P. C. Moore date 4-12-99 Existing System Inspection by: date

HEALTH DEPT. COPY: WHITE OWNER COPY (FINAL) YELLOW OWNER COPY (INITIAL) PINK