IREDELL COUNTY HEALTH DEPARTMENT

STATESVILLE 704-878-5305 MOORESVILLE 704-664-5281

IMPROVEMENT PERMIT / AUTHORIZATION TO CONSTRUCT / OPERATION PERMIT / EXISTING SYSTEM INSPECTION

DATE 4-12-99

PERMIT# 80450 PIN# 4766 95 9764

OWNER OR CONTRACTOR Stikeleather & Associates PHONE: Business 876-0180 Home

ADDRESS 64E TL Riverhill Rd TL Chestnut Grove Rd TR Into Eastgate 1/8 mi Lft.

LOCATION

SUBDIVISION Eastgate BLOCK / SECTION LOT 9 LOT AREA 20837 SITE CLASS. PS DESIGN FLOW 360 L.T.A.R. .3

Septic Tank: 1000 Gallons; STB 1012 Date 2-24-99

Pump Tank: Gallons; PT Date

Pump Make: Model Serial No.

Nitrification Field: No Fields 1 Square Feet 900 Linear Feet 300

No Lines 3 Trench Width 36" Max Trench Bottom Depth 36"

☑ New System ☐ Repair System Type: I. II. III. IV. V

System Description: Gravity Rels

Repair System Description: Pumps To 2570 Rcf

Maintenance Agreement Required: ☐ Yes ☐ No

Gravel Depth N/A ☐ Slab ☐ Crawl Space ☐ Basement w/plumbing ☐ Basement wo/plumbing

☑ House/Mod. Home No. Bedrooms 3

☐ Mobile Home No. Bathrooms 2

☐ Business No. Employees

☐ Other


Water Supply: ☐ Individual ☑ Public ☐ Community

Comments/Conditions:


Comments/Conditions

* Solid pipe From lower hole to lower hole
No Factory Beads

INITIAL SITE SKETCH

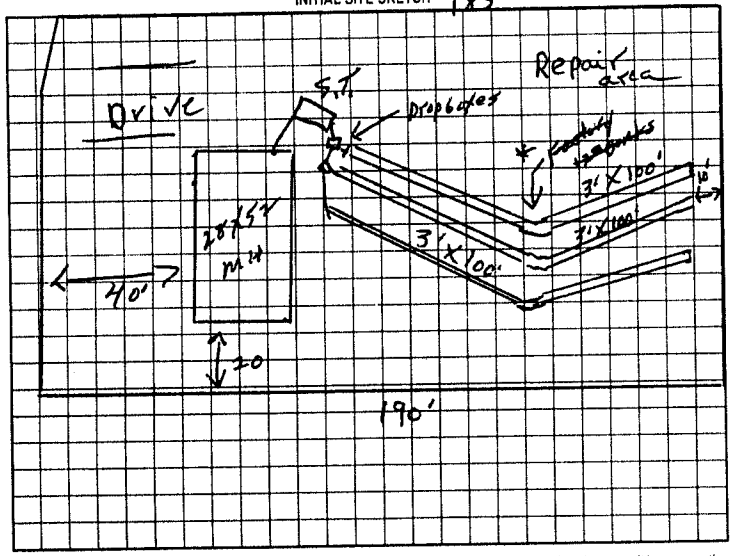

AS BUILT SKETCH

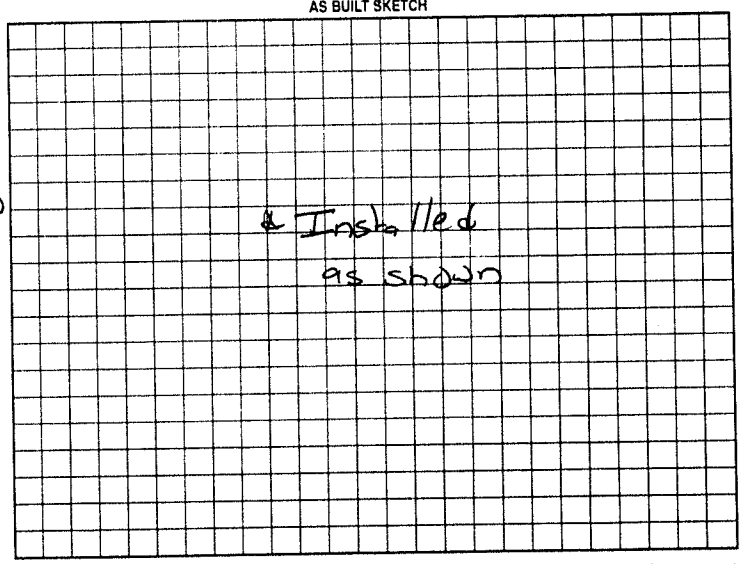

Permit can be suspended or revoked if any false information is supplied toward securing the permit/any unauthorized changes are made to the site/any unauthorized changes are made in the installation of the system. Improvement Permit with plat valid without expiration. Improvement Permit with site plan valid for sixty months. Authorization to Construct is valid for a period equal to that of Improvement Permit – not to exceed sixty months.

Signed: Ben Stikeleather date 4-16-99 Installed by: C & W Septic

Improvement Permit by: R. C. Moore date 4-12-99 Operation Permit by: Mary C Ostwalt date 4-23-99

Authorization to Construct by: R. C. Moore date 4-12-99 Existing System Inspection by: date

HEALTH DEPT. COPY: WHITE OWNER COPY (FINAL): YELLOW OWNER COPY (INITIAL): PINK