IREDELL COUNTY HEALTH DEPARTMENT

STATESVILLE 704-878-5305 MOORESVILLE 704-664-5281

IMPROVEMENT PERMIT / AUTHORIZATION TO CONSTRUCT / OPERATION PERMIT / EXISTING SYSTEM INSPECTION

PERMIT# 91446 PIN# 4766958845 DATE 9/21/00

OWNER OR CONTRACTOR STYKELEATHER & ASSOC. PHONE: Business 876-6847 Home

ADDRESS PO BOX 6286 - STATESVILLE NC 28687

LOCATION 64E - TL RIVERHILL - TL CHESTNUT GROVE - TR EASTGATE ON LT

SUBDIVISION EASTGATE EST BLOCK / SECTION LOT 10 LOT AREA 1.48 AC SITE CLASS. RS DESIGN FLOW 360GPD L.T.A.R. 360/FT2

Septic Tank: 1000 Gallons; STB 100 Date 9/11/00
Pump Tank: 1000 Gallons; PT 274 Date 9/21/00
Pump Make: Goulds Model WE03 1IM Serial No. SO2246415
Nitrification Field: No Fields 1 Square Feet 900 Linear Feet 300
No Lines 4@75' Trench Width 36" Max Trench Bottom Depth 36'

☑ New System ☐ Repair System Type: I, II, III, IV, V, VI
System Description: PUMP 25% REDUCTION
Repair System Description: SAME
Maintenance Agreement Required: ☐ Yes ☑ No

☑ House/Mod. Home No. Bedrooms 3
☐ Mobile Home No. Bathrooms 3
☐ Business No. Employees
☐ Other


☐ Slab ☑ Crawl Space ☐ Basement w/plumbing ☐ Basement wo/plumbing

Water Supply: ☐ Individual ☐ Public ☑ Community

Comments:/Conditions:

Comments:/Conditions: Poly lok filter - infiltrators installed
Lines + tanks checked 11/2/00 GM
Pressure + Electrical checked 5-24-01

INITIAL SITE SKETCH 1" = 50'

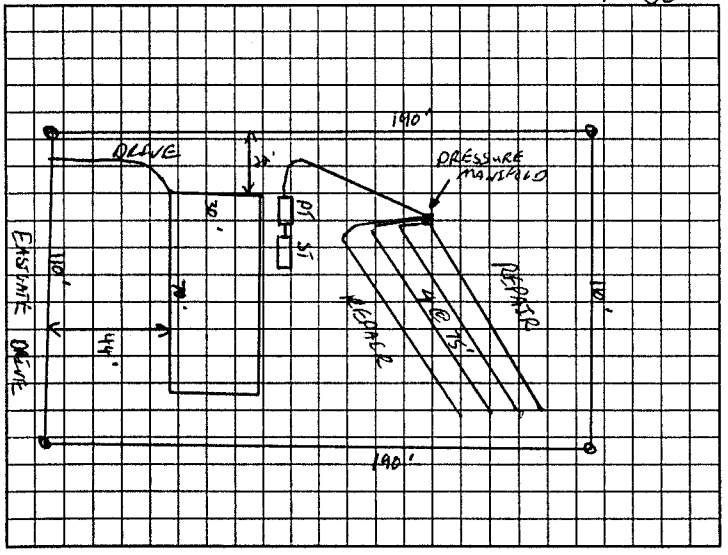

AS BUILT SKETCH

Permit can be suspended or revoked if any false information is supplied toward securing the permit/any unauthorized changes are made to the site/any unauthorized changes are made in the installation of the system. Improvement Permit with plat valid without expiration. Improvement Permit with site plan valid for sixty months. Authorization to Construct is valid for a period equal to that of Improvement Permit – not to exceed sixty months.

Signed: Ben Stykeleather date 9-25-20[illegible] Installed by: COTHERMAN BACKHOE

Improvement Permit by: C. Bly Jr RS date 9/21/00 Operation Permit by: Jon Cook RSI date 5-24-01

Authorization to Construct by: C. Bly Jr RS date 9/21/00 Existing System Inspection by: date

HEALTH DEPT. COPY: WHITE OWNER COPY (FINAL): YELLOW OWNER COPY (INITIAL): PINK