This Permit Voids previous issued OP dated 4-3-01

IREDELL COUNTY HEALTH DEPARTMENT

STATESVILLE 704-878-5305 MOORESVILLE 704-664-5281

IMPROVEMENT PERMIT / AUTHORIZATION TO CONSTRUCT / OPERATION PERMIT / EXISTING SYSTEM INSPECTION

PERMIT# 090349 PIN# 4766-95-9085 DATE 5/15/2002

OWNER OR CONTRACTOR Custom Homes PHONE: Business (704) 871-0860 Home —

ADDRESS

LOCATION Hwy 64 E. @ Riverhill Rd @ Chestnut Grove Rd. (R) Eastgate on Rt

SUBDIVISION Eastgate Estate BLOCK / SECTION LOT 33 LOT AREA .41 Acres SITE CLASS 15 DESIGN FLOW 360 L.T.A.R. .30

Septic Tank: 1,000 Gallons; STB 10/2 Date 2-7-01
Pump Tank: Gallons; PT Date
Pump Make: Model Serial No.
Nitrification Field: No. Fields Square Feet Equ. to 1200 Linear Feet
No Lines 3 (4) Trench Width 36" Max Trench Bottom Depth 36" Gravel Depth N/A

☒ New System ☐ Repair System Type: I, II, III, IV, V, VI
System Description: Gravity -25% Reduction
Repair System Description: Pump - Panel Block
Maintenance Agreement Required: ☐ Yes ☒ No
☐ Slab ☒ Crawl Space ☐ Basement w/plumbing ☐ Basement wo/plumbing


☐ House/Mod. Home No. Bedrooms 3
☒ Mobile Home No. Bathrooms 2
☐ Business No. Employees
☐ Other

Water Supply: ☐ Individual ☒ Public ☐ Community


Comments:/Conditions:
① Replace 4" distribution box if necessary
② Add additional dist box and 3 new lines with 13 Chambers total. Substitute for Footage under paved driveway.
③ maintain proper setbacks

Comments:/Conditions:
① Installed 14 chamber 5 - Infiltrator
② Rerouted Water line that was initially installed between ~~Existing~~ Old & New dist boxes.

INITIAL SITE SKETCH

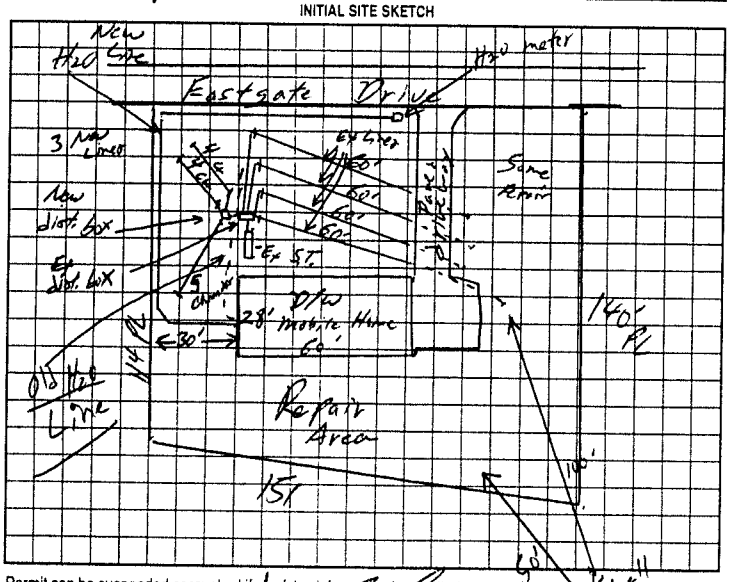

AS BUILT SKETCH

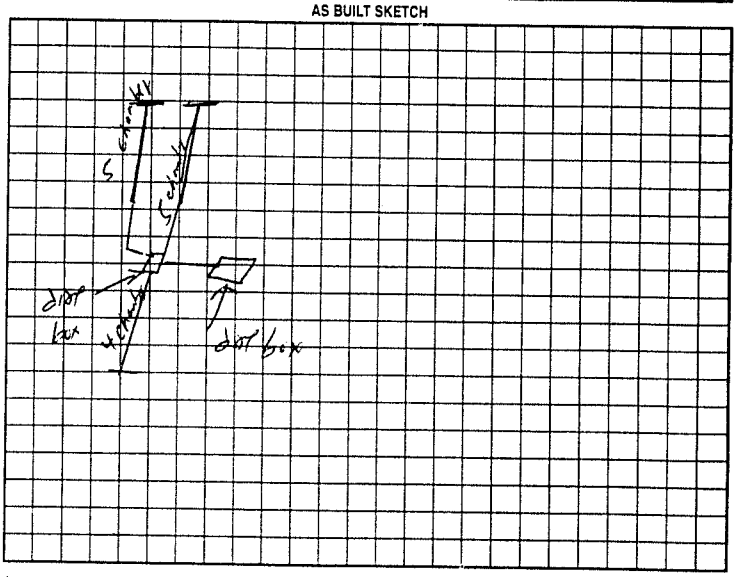

Permit can be suspended or revoked if any false information is supplied toward securing the permit/any unauthorized changes are made to the site/any unauthorized changes are made in the installation of the system. Improvement Permit with plat valid without expiration. Improvement Permit with site plan valid for sixty months. Authorization to Construct is valid for a period equal to that of Improvement Permit – not to exceed sixty months.

Signed: [signature] date 5/16/02 Installed by: Tommy Cothern

Improvement Permit by: [signature] date 5/15/02 Operation Permit by: [signature] date 5/23/02

Authorization to Construct by: [signature] date 5/15/02 Existing System Inspection by: date

HEALTH DEPT COPY: WHITE OWNER COPY (FINAL): YELLOW OWNER COPY (INITIAL): PINK