IREDELL COUNTY HEALTH DEPARTMENT

STATESVILLE 704-878-5305 MOORESVILLE 704-664-5281

IMPROVEMENT PERMIT / AUTHORIZATION TO CONSTRUCT / OPERATION PERMIT / EXISTING SYSTEM INSPECTION

PERMIT# 86570 PIN# 4766959764 DATE 12-2-99

OWNER OR CONTRACTOR Stikeleather + associates PHONE: Business 8766847 Home

ADDRESS PO BOX 6286 Statesville, N.C.

LOCATION 64E TL Riverhill Rd TL Chestnut Grove TR Eastgate 17th lot Rt

SUBDIVISION Eastgate Est. BLOCK / SECTION LOT 31 LOT AREA 18675 SITE CLASS PS DESIGN FLOW 360 L.T.A.R. .137

Septic Tank: 1000 Gallons; STB 1012 Date 10-25-99
Pump Tank: Gallons; PT Date
Pump Make: Model Serial No
Nitrification Field: No Fields 1 Square Feet 960 Linear Feet 320
No Lines 3 Trench Width 36" Max Trench Bottom Depth 36" Gravel Depth 12"

☑ New System ☐ Repair System Type: I, II, III, IV, V, VI
System Description: Conv. Gravity
Repair System Description: Gravity 2520 Rock
Maintenance Agreement Required: ☐ Yes ☐ No
☐ Slab ☐ Crawl Space ☐ Basement w/plumbing ☐ Basement wo/plumbing


☑ House/Mod. Home No. Bedrooms 3
☐ Mobile Home No. Bathrooms 2
☐ Business No. Employees
☐ Other

Water Supply: ☐ Individual ☑ Public ☐ Community

Comments/Conditions:

Comments/Conditions SEPTIC TANK w/ RISERS INSTALLED USING "POLYLOK" FILTER

INITIAL SITE SKETCH 175'

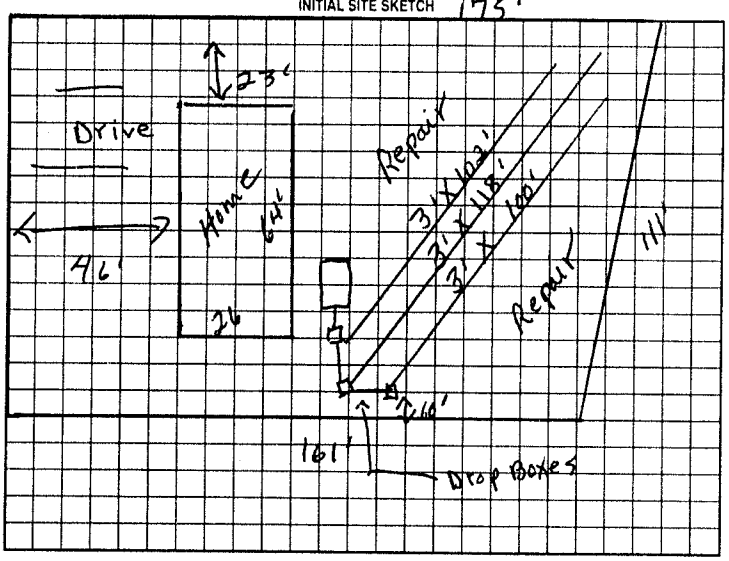

AS BUILT SKETCH

SYSTEM INSTALLED ACCORDING TO INITIAL SITE SKETCH

Permit can be suspended or revoked if any false information is supplied toward securing the permit/any unauthorized changes are made to the site/any unauthorized changes are made in the installation of the system. Improvement Permit with plat valid without expiration/ Improvement Permit with site plan valid for sixty months. Authorization to Construct is valid for a period equal to that of Improvement Permit – not to exceed sixty months.

Signed: David Stikeleather date

Improvement Permit by: D. C. Moore date 12-2-99

Authorization to Construct by: D. C. Moore date 12-2-99

Installed by: C & W GRADING

Operation Permit by: STEVE HENDRICK date 12-23-99

Existing System Inspection by: date

HEALTH DEPT COPY WHITE OWNER COPY (FINAL) YELLOW OWNER COPY (INITIAL) PINK