IREDELL COUNTY HEALTH DEPARTMENT

STATESVILLE 704-878-5305 MOORESVILLE 704-664-5281

IMPROVEMENT PERMIT / AUTHORIZATION TO CONSTRUCT / OPERATION PERMIT / EXISTING SYSTEM INSPECTION

PERMIT# 83001 PIN# 4766959764 DATE 8-3-99

OWNER OR CONTRACTOR Stikeleather + assoc. PHONE: Business 876 6847 Home

ADDRESS PO Box 6286

LOCATION 64E to Rivehill Rd to Chestnut Grove TR Eastgate 12th lot Left

SUBDIVISION ~~Eastgate Est~~ BLOCK / SECTION LOT 12 LOT AREA 20,900 SF SITE CLASS PS DESIGN FLOW 360 L.T.A.R. .33

Septic Tank: 1000 Gallons: STB 825 Date 7-1-99

Pump Tank: Gallons: PT Date

Pump Make: Model Serial No.

Nitrification Field: No Fields 1 Square Feet 810 Linear Feet 270

No Lines 4 Trench Width 36" Max Trench Bottom Depth 36" Gravel Depth N/A

☑ New System ☐ Repair System Type: I, II, III, IV, V, VI

System Description: Gravity 25% Reduction

Repair System Description: Pump to Panels

Maintenance Agreement Required: ☐ Yes ☑ No

☐ Slab ☑ Crawl Space ☐ Basement w/plumbing ☐ Basement wo/plumbing

☐ House/Mod. Home No. Bedrooms 3

☑ Mobile Home No. Bathrooms 2

☐ Business No. Employees

☐ Other


Water Supply: ☐ Individual ☑ Public ☐ Community

Comments:/Conditions:


Comments /Conditions

4 Driveway may need to be located lowerside of propelty to keep off of system.

INITIAL SITE SKETCH

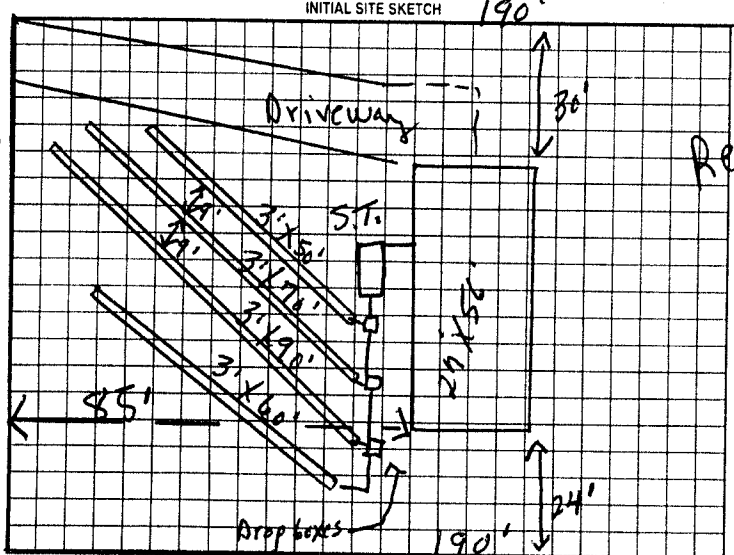

AS BUILT SKETCH

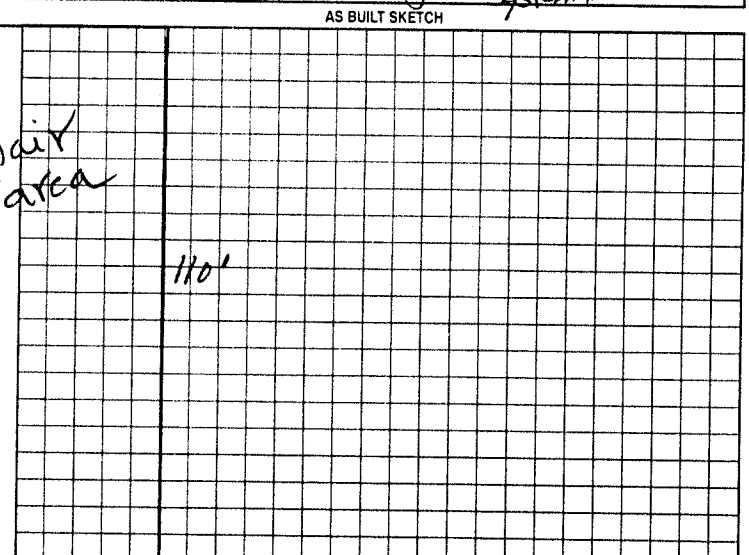

110' Street

Permit can be suspended or revoked if any false information is supplied toward securing the permit/any unauthorized changes are made to the site/any unauthorized changes are made in the installation of the system. Improvement Permit with plat valid without expiration. Improvement Permit with site plan valid for sixty months. Authorization to Construct is valid for a period equal to that of Improvement Permit – not to exceed sixty months.

Signed: David Stikeleather date 8-11-99 Installed by: C & W Enterprises

Improvement Permit by: J. C. Moore date 8-3-99 Operation Permit by: Mary Coffers date 8-26-99

Authorization to Construct by: J. C. Moore date 8-3-99 Existing System Inspection by: date

HEALTH DEPT COPY WHITE OWNER COPY (FINAL) YELLOW OWNER COPY (INITIAL) PINK