IREDELL COUNTY HEALTH DEPARTMENT

STATESVILLE 704-878-5305 MOORESVILLE 704-664-5281

IMPROVEMENT PERMIT / AUTHORIZATION TO CONSTRUCT / OPERATION PERMIT / EXISTING SYSTEM INSPECTION

PERMIT# 82083 PIN# 4766959764 DATE 7-1-99

OWNER OR CONTRACTOR John Lathrop PHONE: Business _____ Home _____

ADDRESS _____

LOCATION Rivershill TL Chestnut Grove TR Eastgate Left Towards entonlgt

SUBDIVISION Eastgate Est. BLOCK / SECTION _____ LOT 14 LOT AREA .47acres SITE CLASS PS DESIGN FLOW 480 L.T.A.R. .13

Septic Tank: 1000 Gallons; STB 1012 Date 5-28-99
Pump Tank: _____ Gallons; PT _____ Date _____
Pump Make: _____ Model _____ Serial No. _____
Nitrification Field: No Fields 1 Square Feet 1200 Linear Feet 400
No Lines 5 Trench Width 36" Max Trench Bottom Depth 36" Gravel Depth N/A

☑ New System ☐ Repair System Type: I, II, III, IV, V, VI
System Description: Gravity 25% Red
Repair System Description: " " "
Maintenance Agreement Required: ☐ Yes ☑ No


☐ House/Mod. Home ☑ Mobile Home ☐ Business ☐ Other
No. Bedrooms 4 No. Bathrooms 2 No. Employees _____
☐ Slab ☑ Crawl Space ☐ Basement w/plumbing ☐ Basement wo/plumbing

Water Supply: ☐ Individual ☑ Public ☐ Community


Comments/Conditions:

Comments/Conditions:
* old catch basin just above 1st line - filled in

INITIAL SITE SKETCH

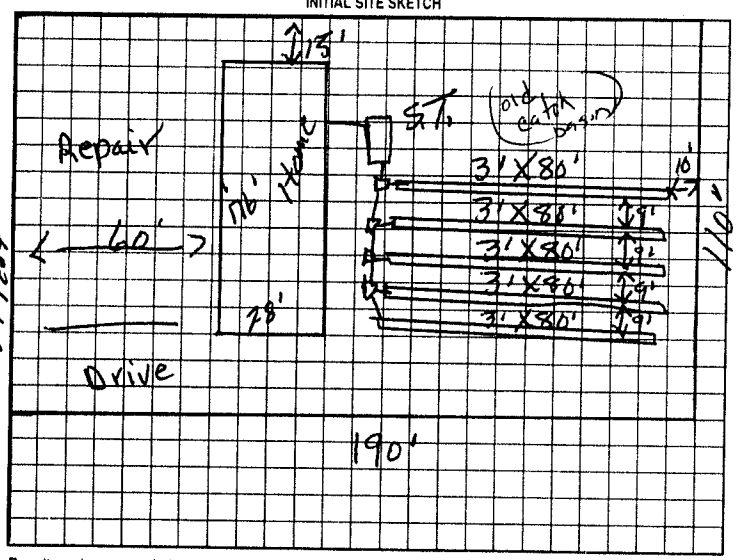

AS BUILT SKETCH

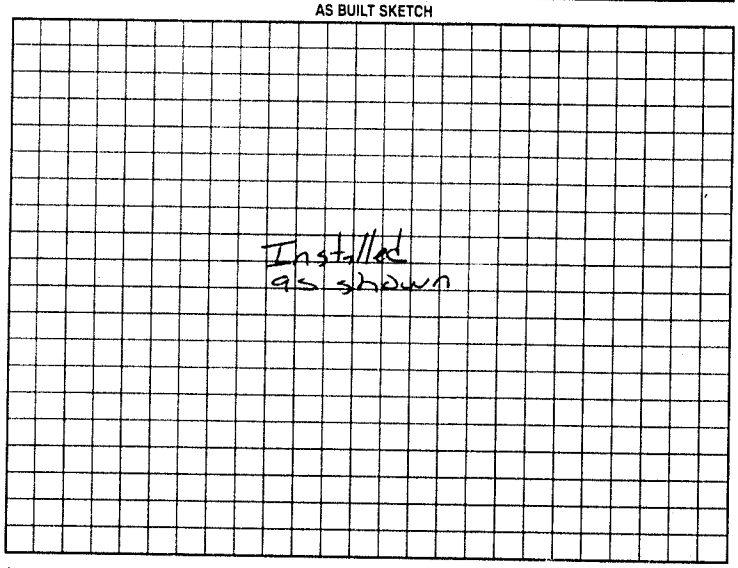

Permit can be suspended or revoked if any false information is supplied toward securing the permit/any unauthorized changes are made to the site/any unauthorized changes are made in the installation of the system. Improvement Permit with plat valid without expiration. Improvement Permit with site plan valid for sixty months. Authorization to Construct is valid for a period equal to that of Improvement Permit – not to exceed sixty months.

Signed: Tom Cecil date 2/13/99 Installed by: A-1 Backhoe

Improvement Permit by: R.C. Moore date 7-1-99 Operation Permit by: Mark Courtney date 8-12-99

Authorization to Construct by: R.C. Moore date 7-1-99 Existing System Inspection by: _____ date _____

HEALTH DEPT COPY WHITE OWNER COPY (FINAL) YELLOW OWNER COPY (INITIAL) PINK