IREDELL COUNTY HEALTH DEPARTMENT

Statesville Office (704) 878-5305 Mooresville Office (704) 660-3625 PERMIT # 177525

IMPROVEMENT PERMIT / AUTHORIZATION TO CONSTRUCT / OPERATION PERMIT / EXISTING SYSTEM R PIN # 4767106764

APPLICANT: Dixieland Inc. APPLICANT ADDRESS: 133 Redemption Rd.

SITE ADDRESS: Old Mocksville Hwy PHONE: 704-876-6162 ALT. PHONE: N/A


SITE DIRECTIONS: Hwy 64 E TL Old Mocksville Rd. Lot on Left ~1 mile past Jane Sowers Rd.

SUBDIVISION: N/A SECTION: N/A LOT # N/A LOT AREA: 2.0 acres DESIGN FLOW: 360 gpd L.T.A.R.: 0.3

Septic Tank	1000 (gal)	STB	1012-1600	Date	5-23-13	☐ New System ☐ Repair ☐ Expansion	System Type: I II (III) IV V VI	☑ Residence	No. Bedrooms 3	Water Supply
Pump Tank	(gal)	PT		Date		System Description:	25% Reduction	☐ Business	No. Persons	☐ Private
Pump Make		Model		Serial #		Repair System Description:	25% Reduction	☐ Other	No. Employees	☑ Public
# Nitrification Fields	1	# Lines	3	Linear Ft:	300	Maintenance Agreement Required:	☐ YES ☑ NO	☐ Slab	☐ Crawl Space	☐ Community
Trench Width	2'-0"	Max. Trench Bottom Depth	36"	Gravel Depth	N/A		☑ GRAVITY ☐ PRESSURE	☑ Basement w/plumbing		☐ Basement w/o plumbing

Comments / Conditions: Install a 25% Reduction system on contour with serial distribution.

INITIAL SITE SKETCH

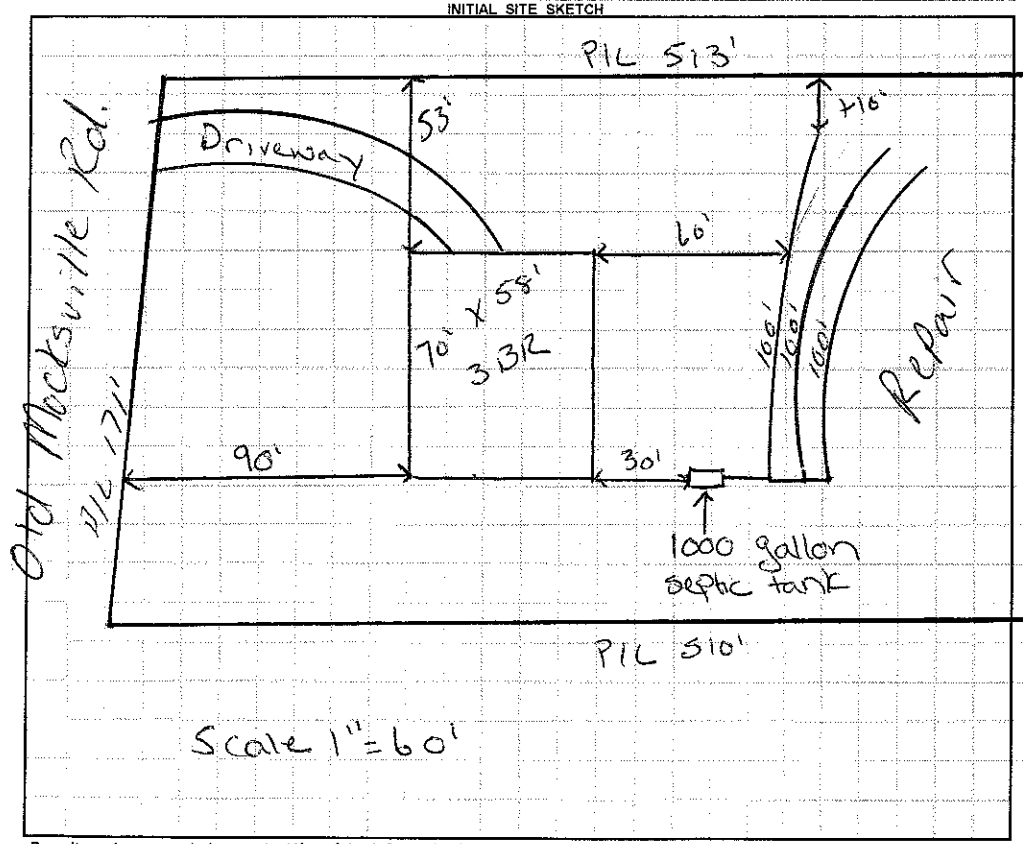

AS BUILT SKETCH

- Red Polylok filter installed
- 2" PVC tank marker installed
- Quick 4 Chambers installed
- Installed as drawn

Permit can be suspended or revoked if any false information is supplied toward securing the permit / any unauthorized changes are made to the site / any unauthorized changes are made in the installation of the system. **CONTACT A LOCATOR SERVICE PRIOR TO ANY EXCAVATION**

☐ **IMPROVEMENT PERMIT** *with plat valid without expiration.* ☑ **IMPROVEMENT PERMIT** *with site plan valid for 60 mos.* ☑ **AUTHORIZATION TO CONSTRUCT** *valid for period equal to IMPROVEMENT PERMIT--not to exceed 60 mo.*

Owner / Applicant Signature: [signature] Date: 3-20-13 Installed by: Steve Jordan

IMPROVEMENT PERMIT by: Justin Henderson Date: 3-20-13 OPERATION PERMIT by: Justin Henderson Date: 12-3-13

AUTHORIZATION TO CONSTRUCT by: Justin Henderson Date: 3-20-13 Existing System Inspected by: Date:

Health Dept. Copy - WHITE Applicant (Final Approval) - YELLOW Applicant (Conditional Approval) - PINK